


T.15S., R.3 W., W.M.

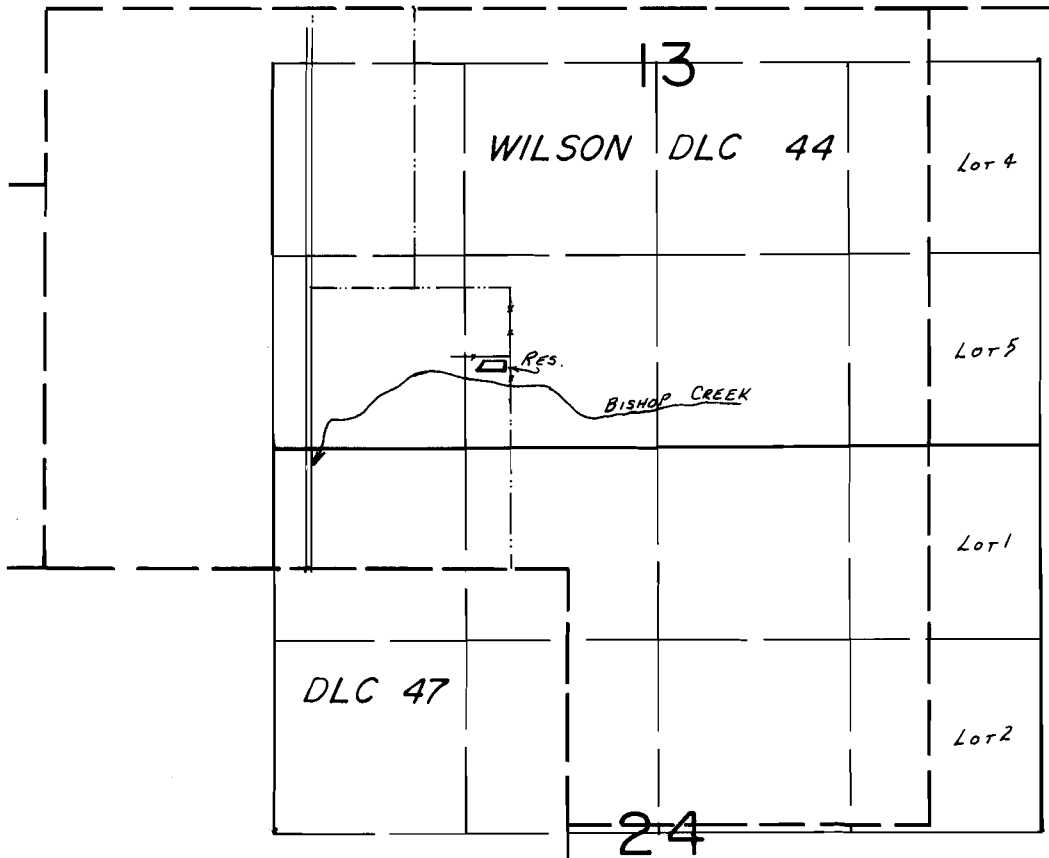

RESERVOIR LOC: 2500'S. & 3070'E. FROM NW COR. WILSON DLC 44.

FINAL PROOF SURVEY UNDER

Application No. R-49159 Permit No. R-5982
IN NAME OF

EDWIN R. & WANDA L. LEABO

Surveyed JULY 2, 1980, by S.C. BROWN