


T.36 S., R.1 E., W.M.

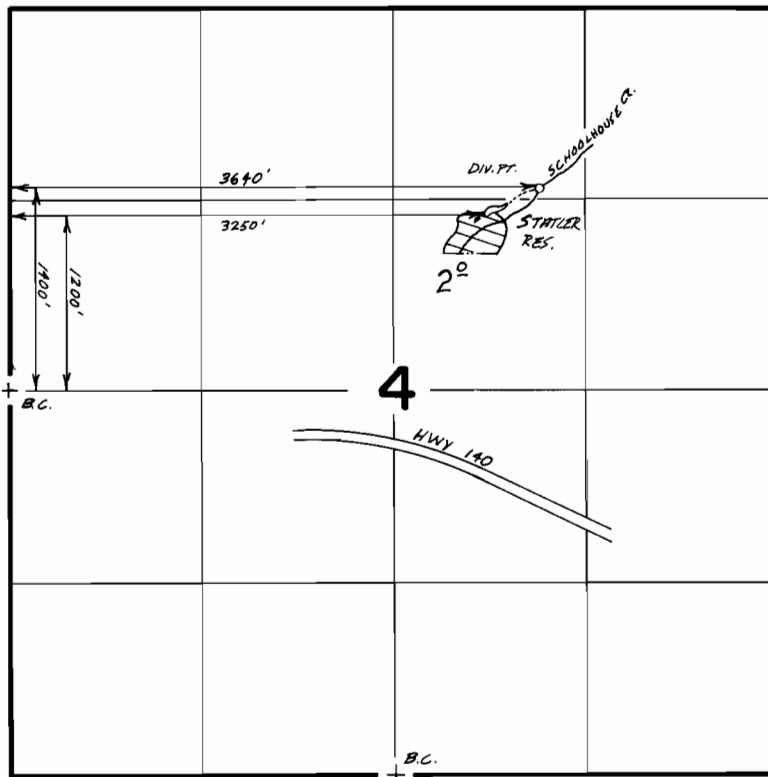

SCALE. 1"=1320'

FINAL PROOF SURVEY UNDER

R-49738 R-6044

Application No. 49739 Permit No. 37247
IN NAME OF

ELLIOTT E. STATLER

Surveyed JUNE 12, 1984, by B.S. JAMES