


T.3S. R.5W. W.M.

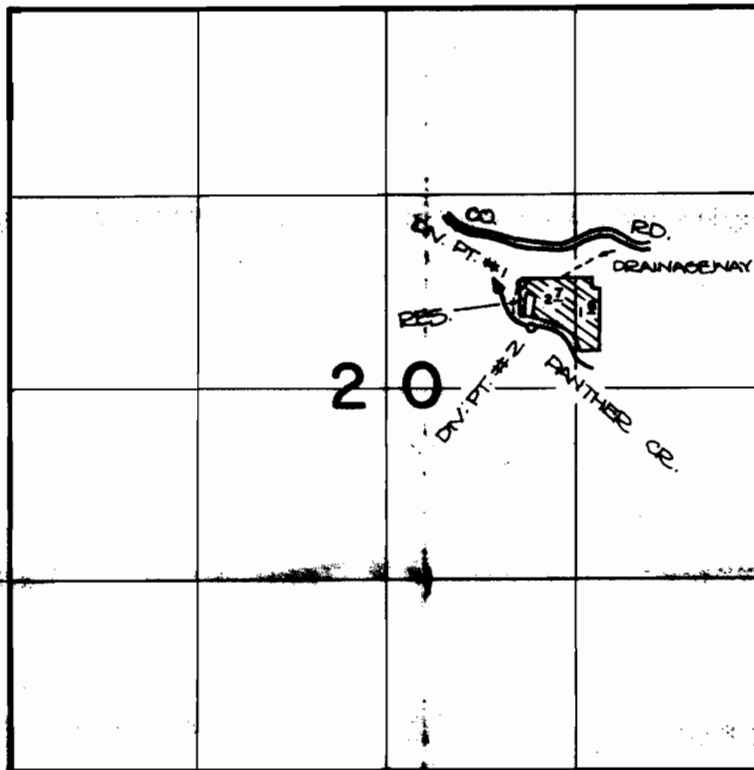

DIVERSION POINT #1 IS LOCATED 1875' S. AND 980' E. FROM THE N. 1/4 CORNER. DIVERSION POINT #2 IS LOCATED 2200' S. AND 980' E. FROM THE N. 1/4 CORNER.

FINAL PROOF SURVEY UNDER

R-52495 R-6113

Application No. ~~52496~~ Permit No. 37771.....

IN NAME OF

ALAN M. DALTON

Surveyed OCT. 21, 1983, by P.R. Pappas...