


T. 6S., R. 6W., W.M.

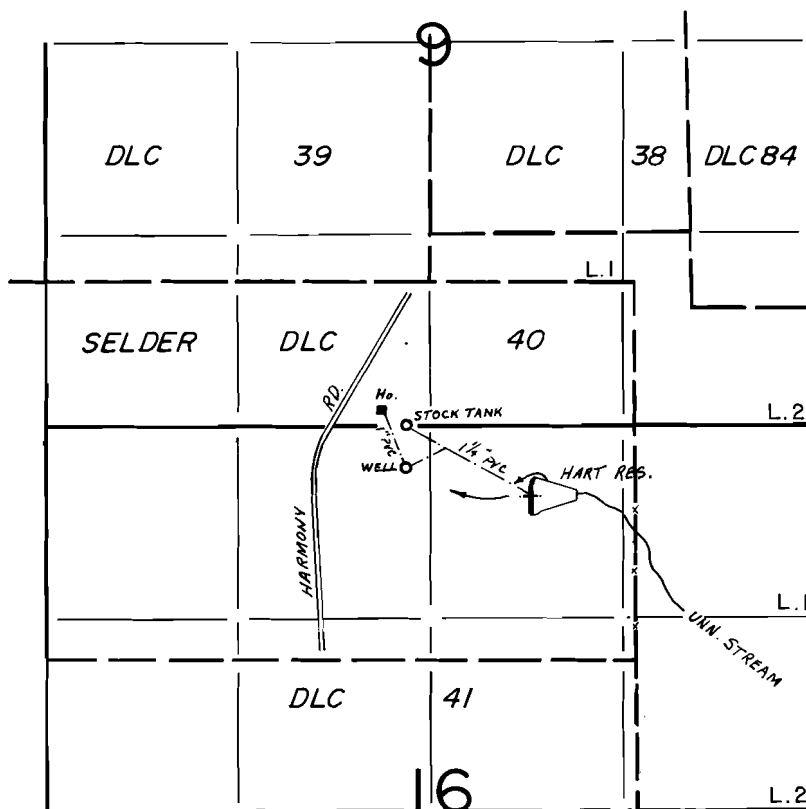

DIV. PT. LOC. 1150' N. & 720' W. FROM SE COR. SELDER DLC 40

FINAL PROOF SURVEY UNDER

R-50362 R-6269
 Application No. ~~50363~~ Permit No. ~~39116~~.....
 IN NAME OF

.....**JOHN J. HART**.....

Surveyed JUNE 1..... 1979... by R.G. MUCKEN.....