


T. 6S., R. 6W., W.M.

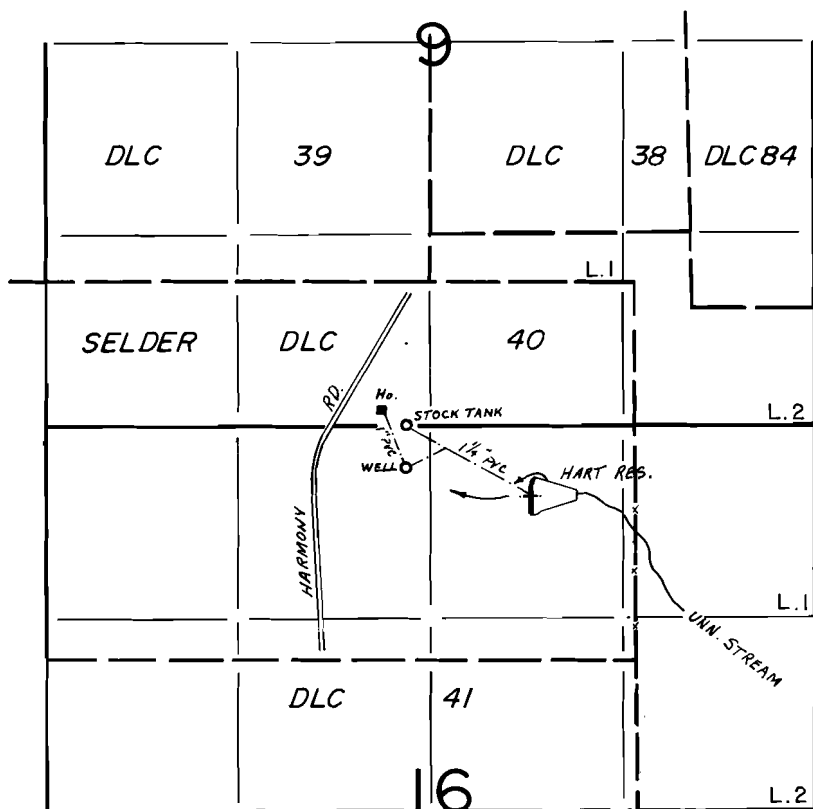

DIV. PT. LOC. 1150' N. & 720' W. FROM SE COR. SELDER DLC 40

FINAL PROOF SURVEY UNDER

R-50362 R-6269
 Application No. 50363 Permit No. 39116.....
 IN NAME OF

JOHN J. HART

Surveyed JUNE 1..... 1979.., by R.G. MUCKEN.....