



T.36S., R.1E., W.M.

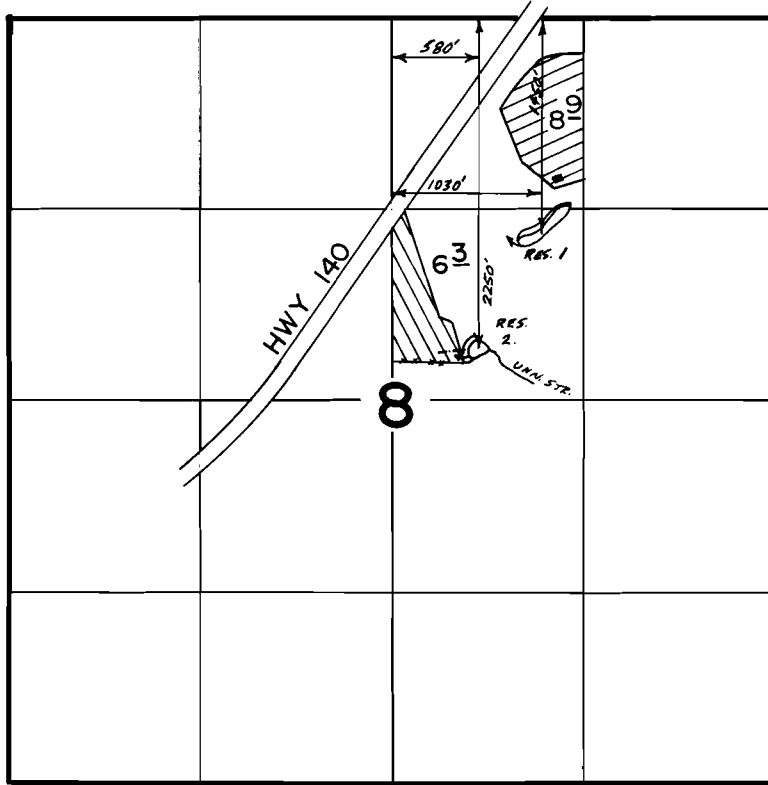

Scale 1" = 1320'

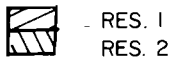

FINAL PROOF SURVEY UNDER

R-53281 R-6327

Application No. ~~53282~~ Permit No. ~~39539~~.....

IN NAME OF

HAROLD R. & or ERMA J. PAYNE

Surveyed JUNE 13, 1984, by B.S. JAMES.....