


T. 24S., R. 4W., W.M.
SEC. 18

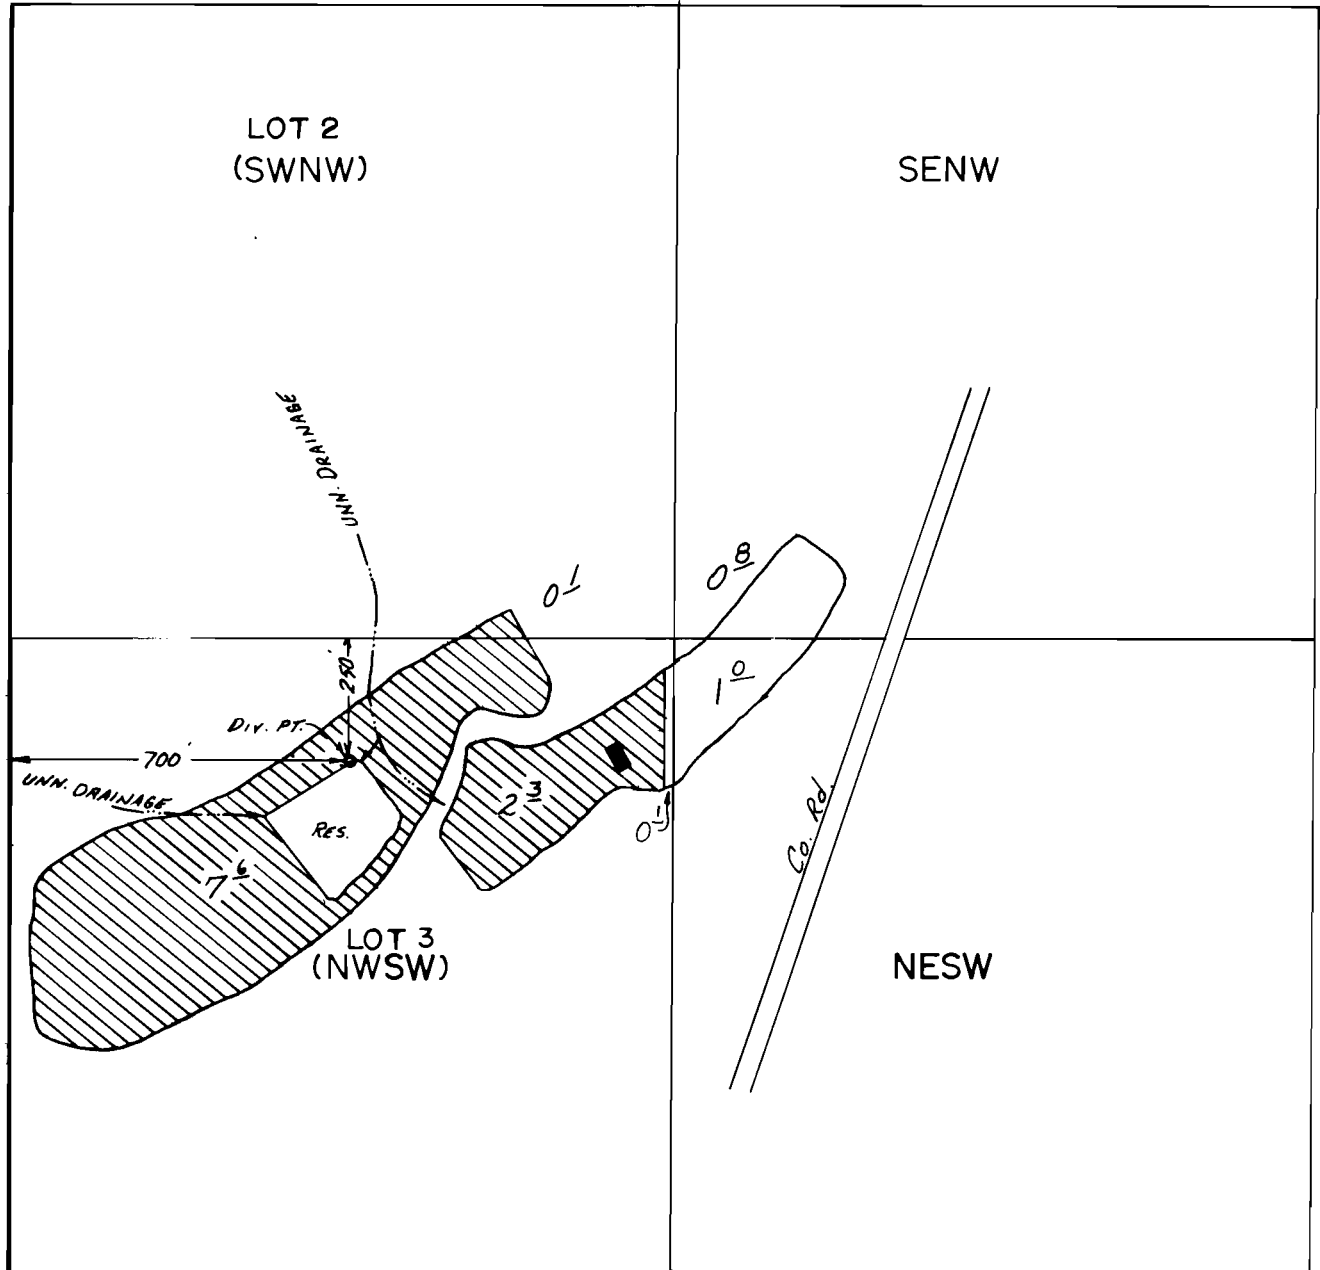

SCALE: 1" = 400'

FINAL PROOF SURVEY
UNDER

R-53557 R-6506
Application No. 53558 Permit No. 40828
IN NAME OF

MILDRED KANIPE

Surveyed MAY 20, 1980, by J.S. DONALDSON