


I. 24S., R. 4W., W.M.
SEC. 18

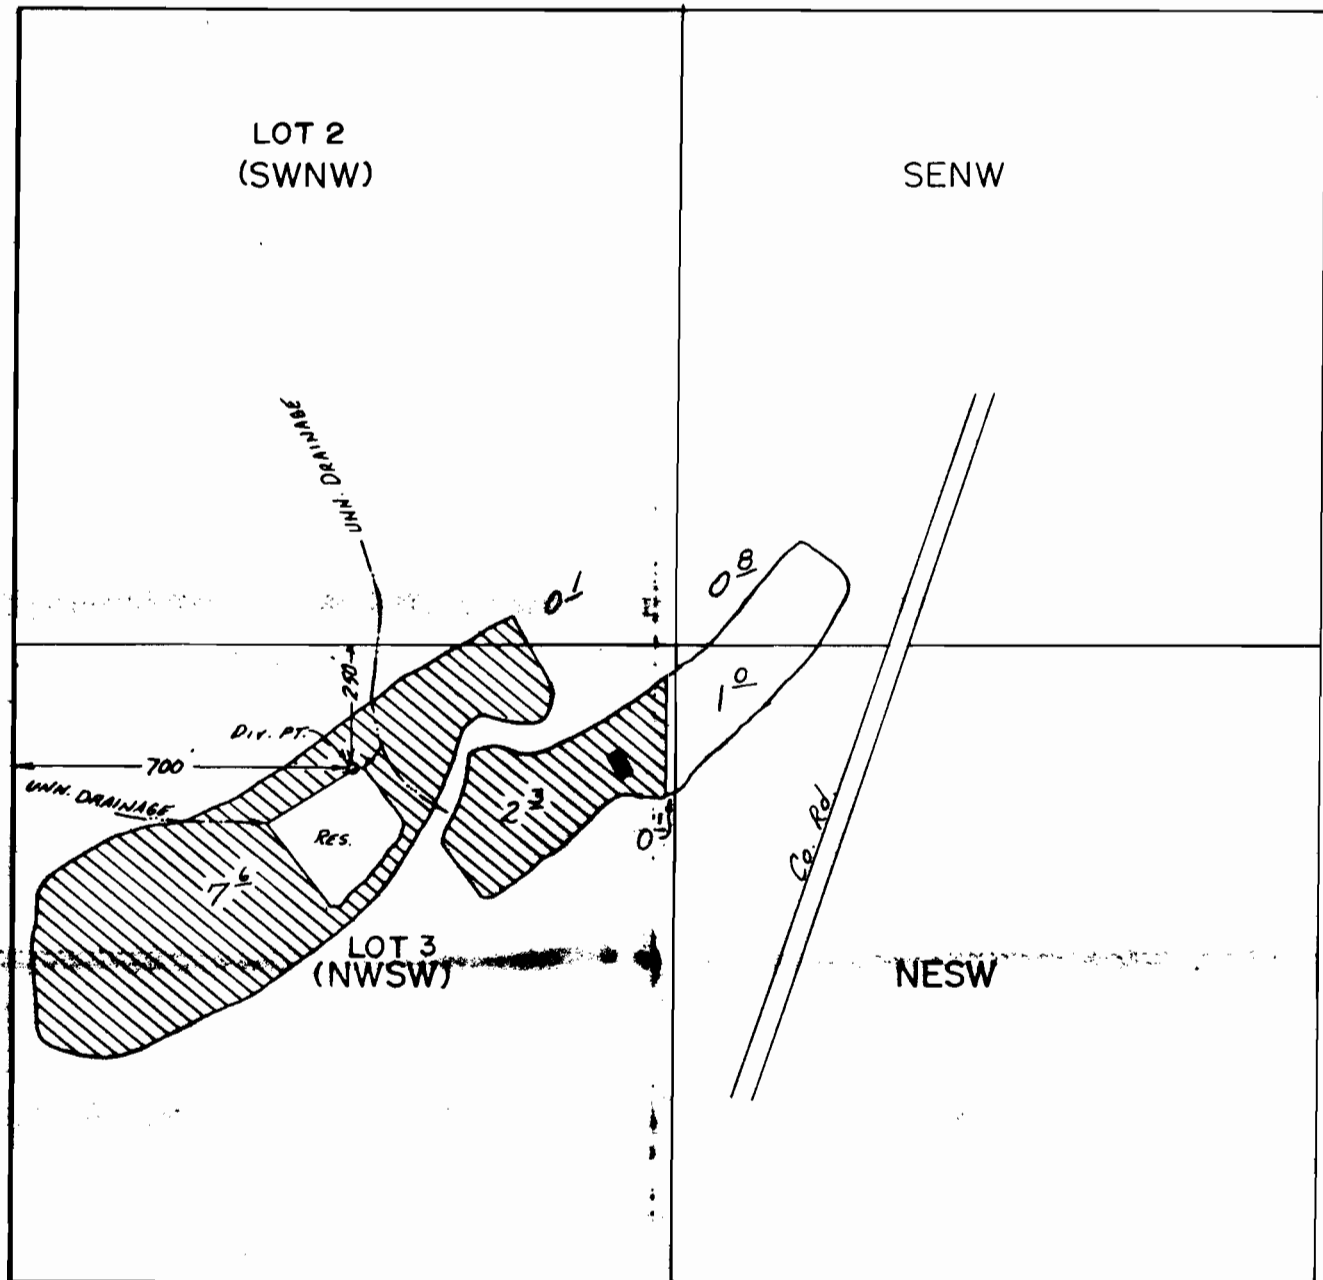

SCALE: 1" = 400'

FINAL PROOF SURVEY
UNDER

R-53557 R-6506
Application No. **53558** Permit No. **40828**
IN NAME OF

MILDRED KANIPE

Surveyed MAY. 20... 19.80, by J.S. DONALDSON