


T. 35 S., R. 6 W., W. M.

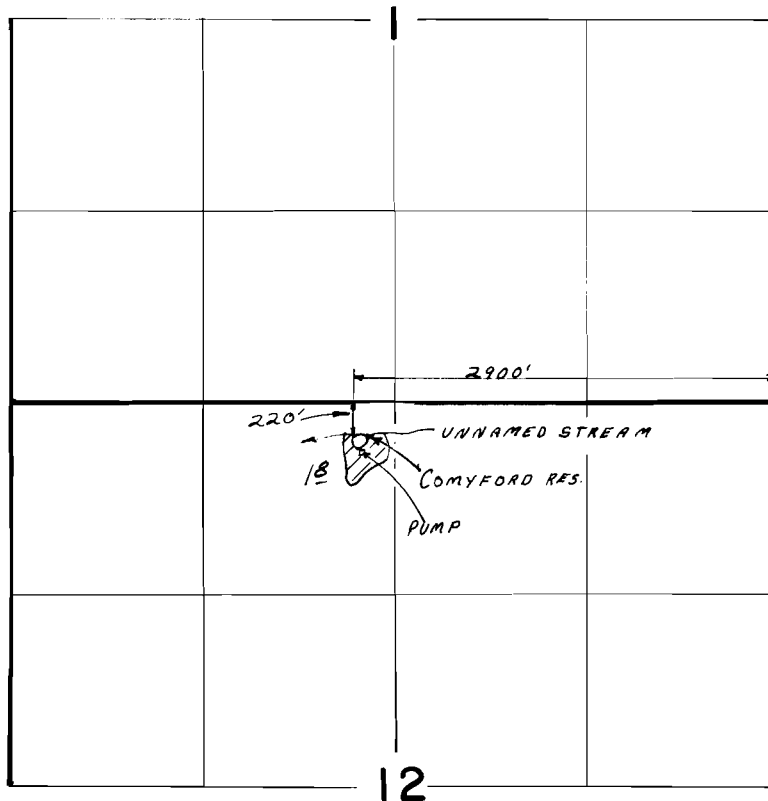

Scale: 1" = 1320'

FINAL PROOF SURVEY

UNDER

R-54480

R-6515

Application No. 54481 Permit No. 40836
IN NAME OF

CHARLES E. COMYFORD

Surveyed JUL 16, 1986, by B. S. JAMES.