


T.23S. R.4W. W.M.

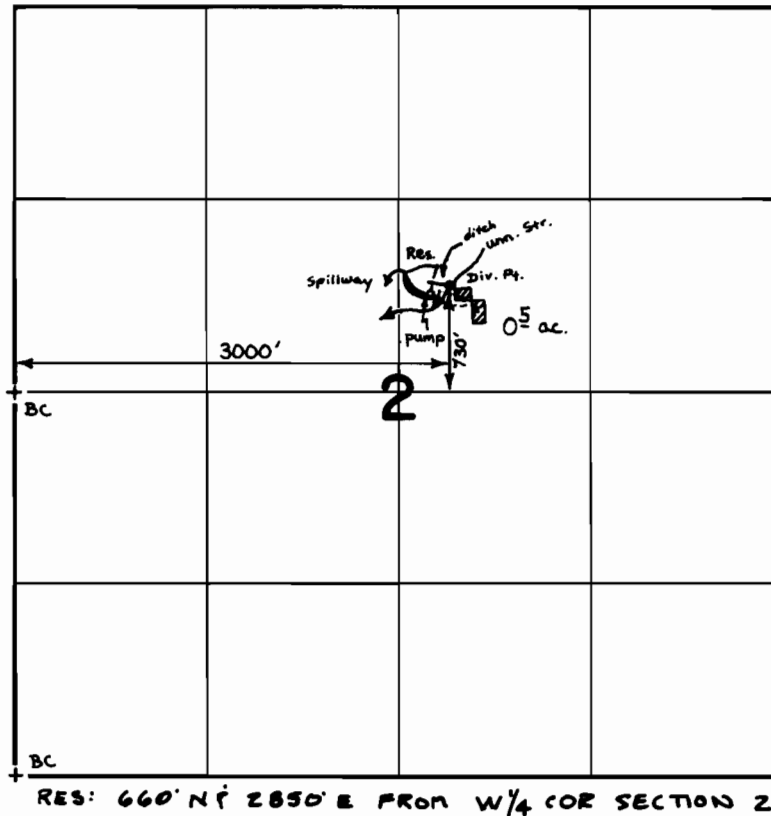

SCALE: 4" = 1 mile

FINAL PROOF SURVEY

UNDER

R-53798 R-6520
Application No. 53799 Permit No. 40907
IN NAME OF

KARL RICHARD HESS

Surveyed May 28, 1980, by S. Donaldson