


T.23S. R.4W. W.M.

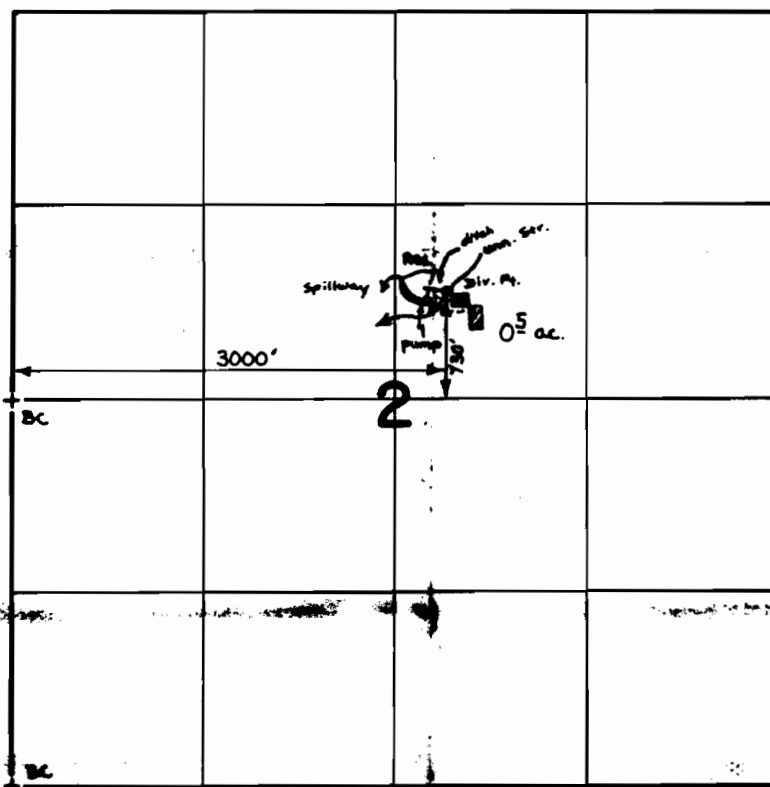

RES: 660' NT 2850' E FROM W $\frac{1}{4}$  COR SECTION 2

SCALE: 4" = 1 mile

# FINAL PROOF SURVEY UNDER

R-53798 R-6520  
Application No. 53799 Permit No. 40907  
IN NAME OF

KARL RICHARD HESS

Surveyed May 28, 1980, by S. Donaldson