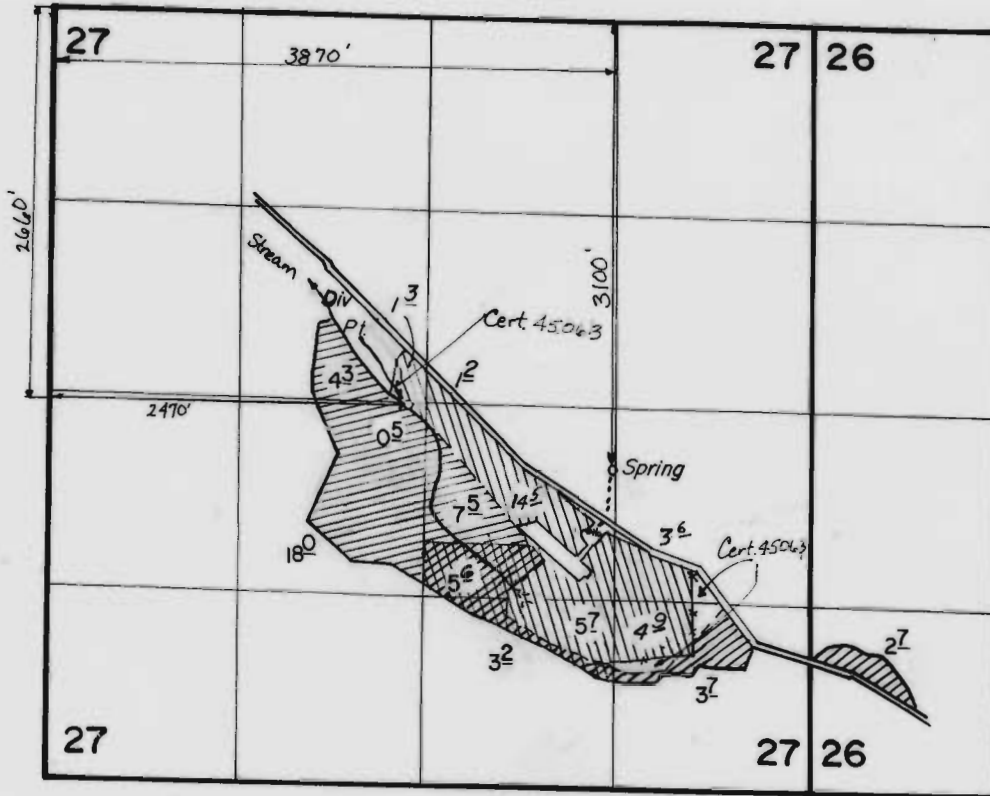


T. 37 S., R. 5 W., W.M.


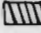


FINAL PROOF SURVEY
UNDER

TRANSFER NO. P-87
Application No. 43746 Permit No. 32691
IN NAME OF

MILTON, ROBERT AND RECO HILL

Surveyed MAY 13, 1975, by J. E. GOULD
JULY 27, 1982 B. R. SUND

 primary
 supplemental