


# T.4&5S.R.10W.W.M.

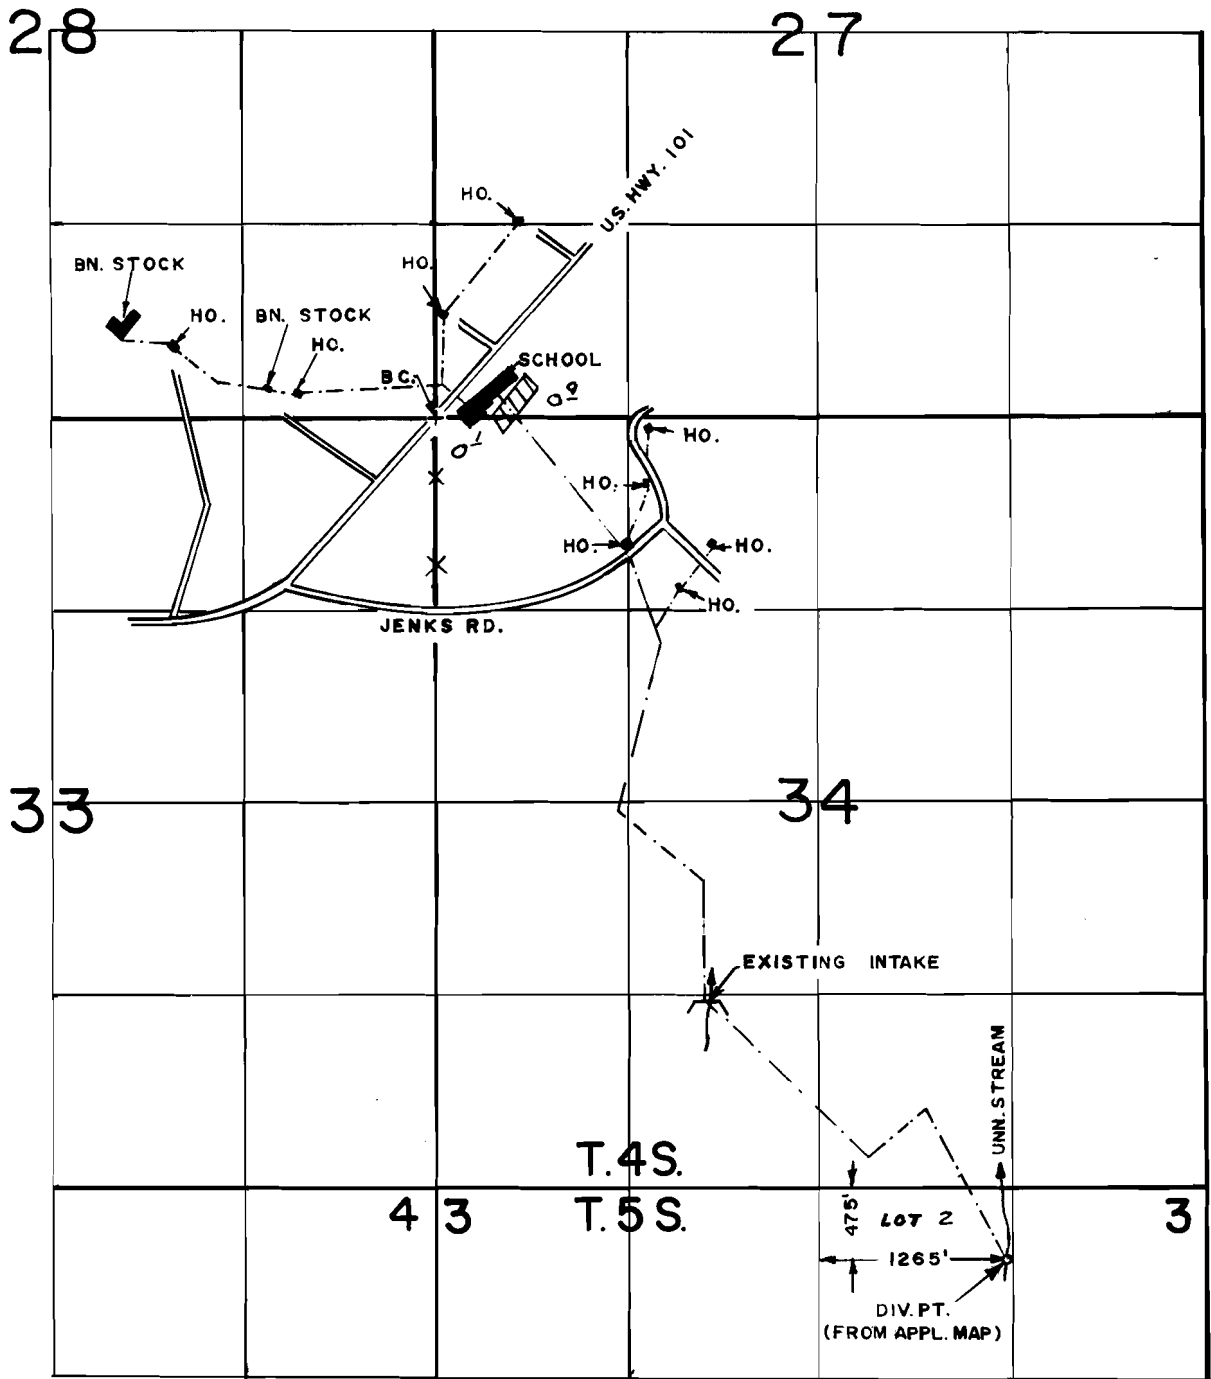

## FINAL PROOF SURVEY UNDER

Application No. 44105. Permit No. 33135.....  
IN NAME OF

..... CLOVERDALE GRADE SCHOOL .....

Surveyed JAN. 23 & 25 1980., by R.G. MUCKEN.....