


P- 39131

51766

T.14S., R.31E., W.M.

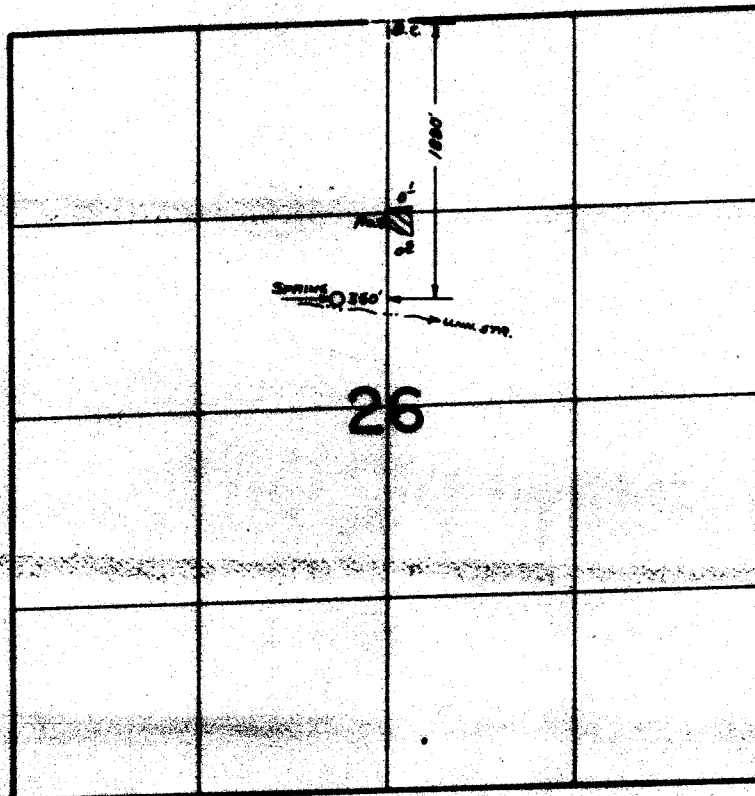

FINAL PROOF SURVEY
UNDER

Application No. 51749 Permit No. 39131
IN NAME OF

D. R. JOHNSON

Surveyed Oct. 1, 1981, by S. C. BROWN

Approved by [Signature]