


T. 35 S., R. 3 W., W.M.

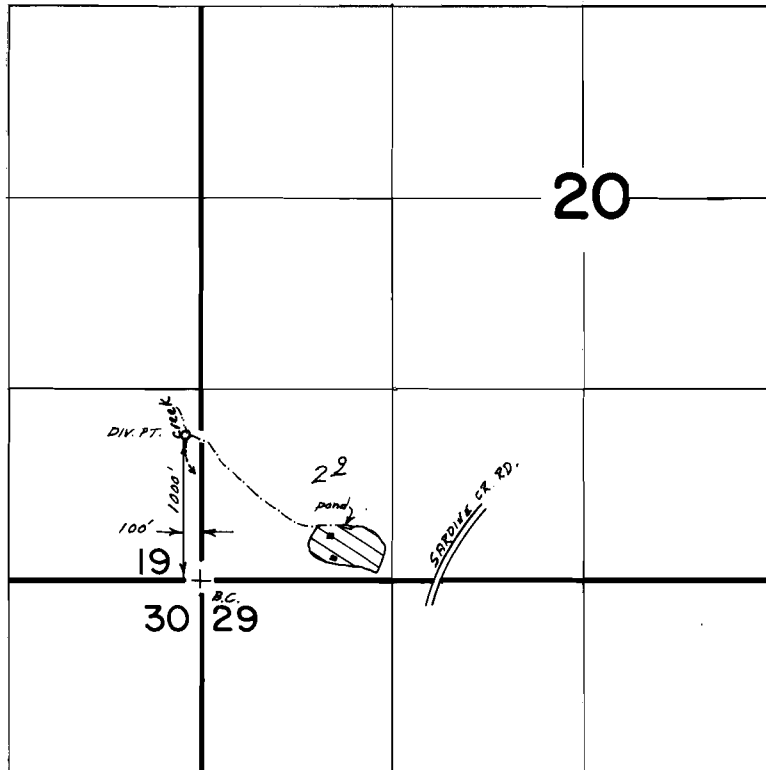

Scale 1" = 1320'

FINAL PROOF SURVEY
UNDER

Application No. 53242. Permit No. 39510.....
IN NAME OF

..... CLEMENT..... STOCKARD..... ET. AL.

Surveyed Oct. 7... 1986, by B.S. JAMES.....