T. 8S., R. 6W., W.M.

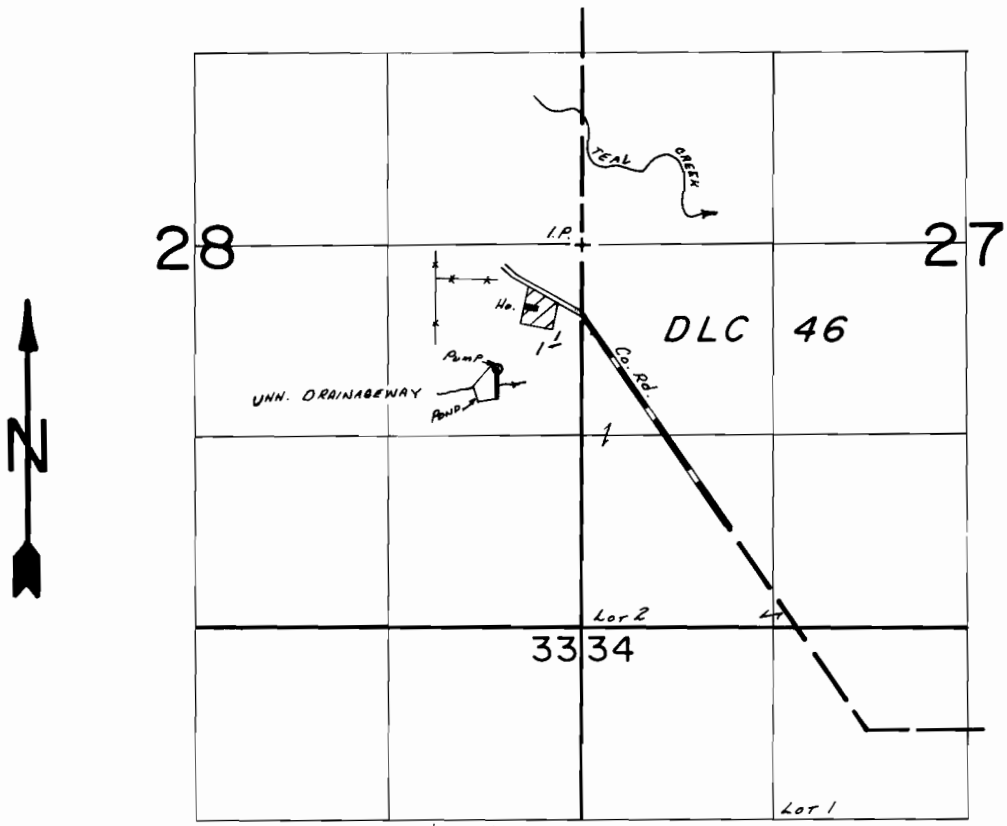

DIV. PT. LOC: 970'S. & 570'W. FROM E. 1/4 COR. SEC. 28.

SCALE: 1"=1320'

FINAL PROOF SURVEY
UNDER

Application No. 52879 Permit No. 39907
IN NAME OF

JOHN QUALEY

Surveyed AUG. 8 1983, by L. M. TOLL

PTS 1983-Y

BWB