
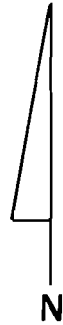


T. 1 S., R. 8 W., W.M.

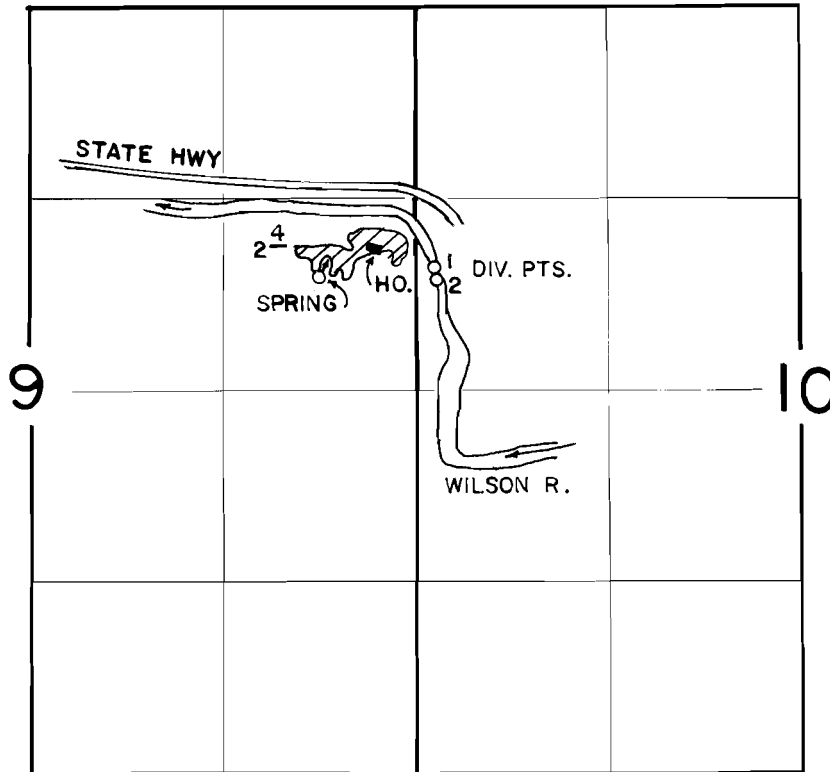

SCALE
1" = 1320'

SPRING LOC. 1850' S. & 650' W. OF NE. COR. SEC 9
DIV. PTS. LOC. 1, 1810' S. & 120' E.;
2, 1870' S. & 130' E. ALL FROM NE. COR
SEC. 9

FINAL PROOF SURVEY
UNDER

Application No. 53156 Permit No. 40317
IN NAME OF

LEROY PERKINS

Surveyed JUN. 12. 1984., by P. PAGTER