



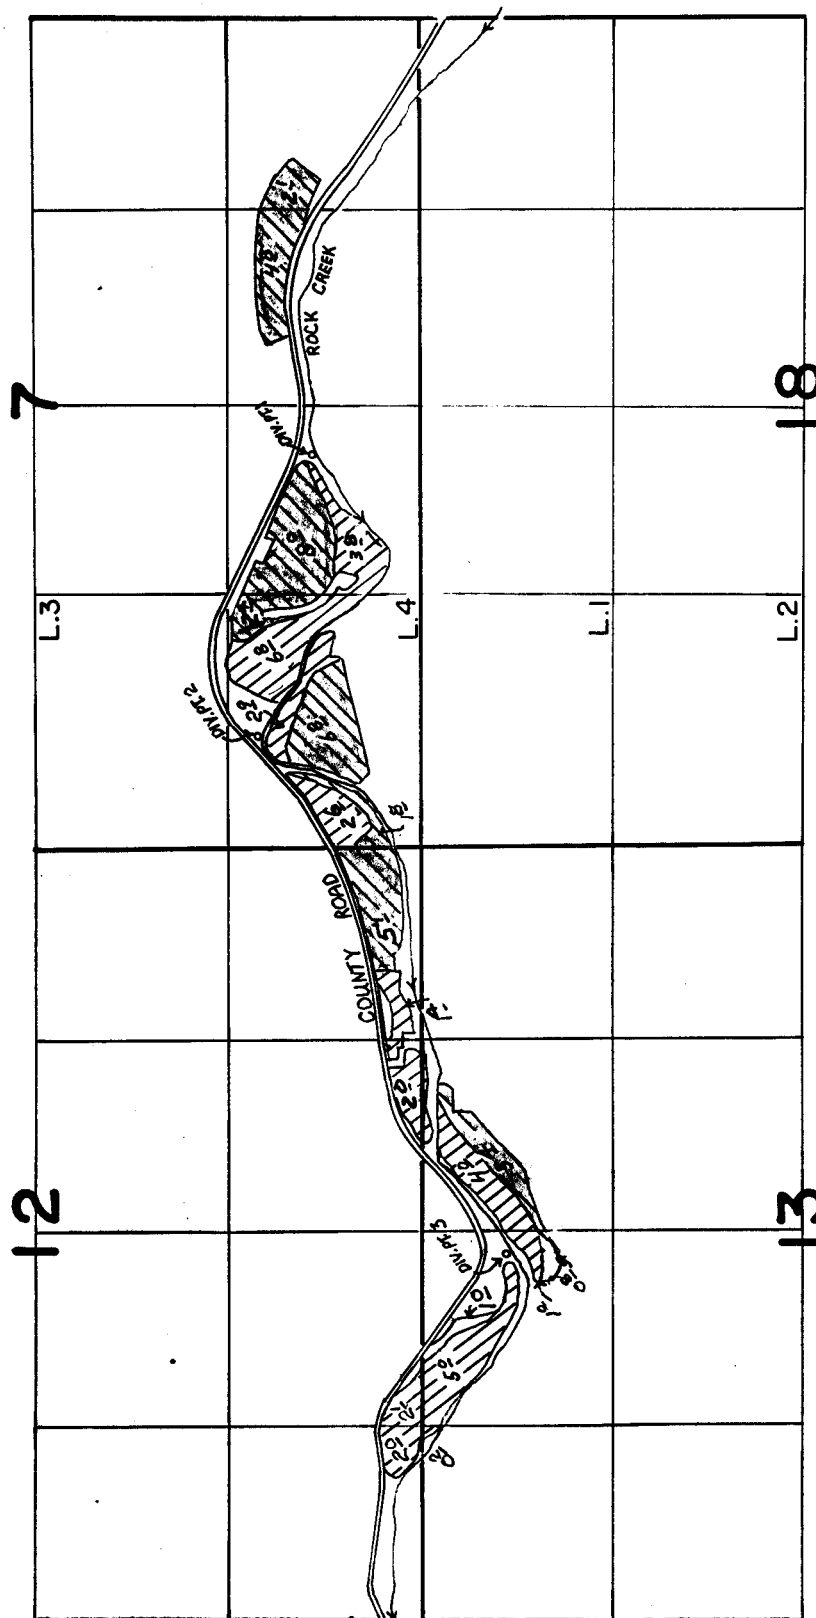

# T.1N. R.19 & 20 E. WM.

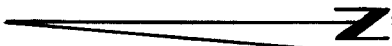

  
 SCALE: 1"=1320'

DIV. PT. 1 LOCATED 740' N. AND 2700' E. FROM SW. COR. SEC. 7  
 DIV. PT. 2 LOCATED 1120' N. AND 770' E. FROM SW. COR. SEC. 7  
 DIV. PT. 3 LOCATED 580' S. AND 2790' W. FROM SW. COR. SEC. 7

-  PRIMARY, PER. 38739  
 PER. 40704, WINTER RIGHT  
 SUPPL. TO PER. 38739
-  PRIMARY, CERT. 2830  
 PER. 40704, WINTER RIGHT  
 SUPPL. TO CERT 2830

## FINAL PROOF SURVEY UNDER

Application No. 51308 38739  
 53929 Permit No. 40704  
 IN NAME OF

**CHARLES T. & EDITH L. WELP**

Surveyed May 21 1985, By V.L. CHURCH

**P. 38739**  
 56572  
 57667