


T. 1 S., R. 9 W., W.M.

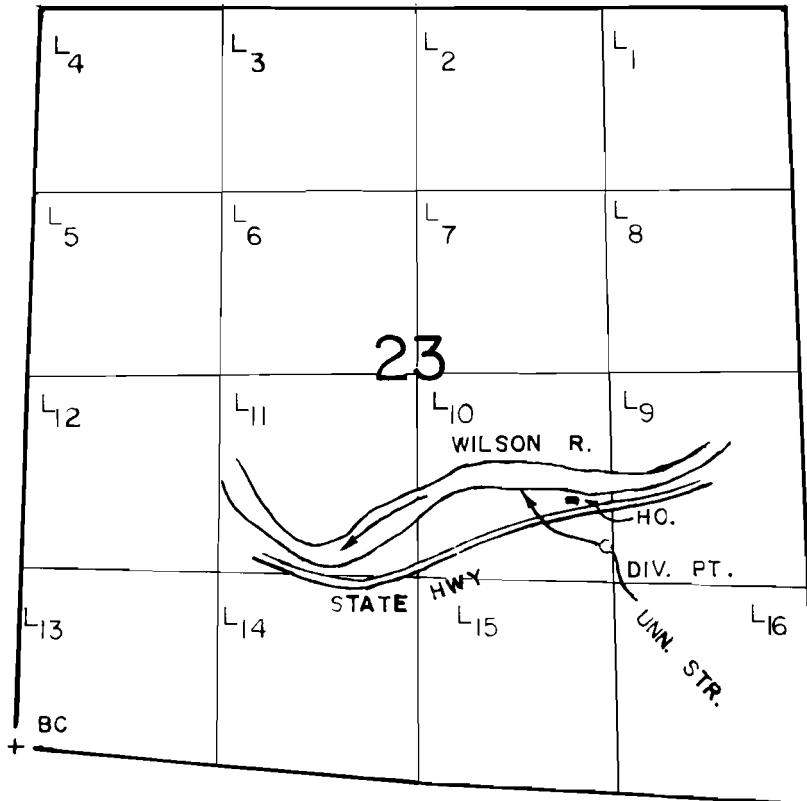

P.O.D. Loc. : 1350' N. & 4050' E. from SW Cor. Sec. 23.

FINAL PROOF SURVEY
UNDER

Application No. 54297... Permit No. 40722...

IN NAME OF

JAMES WYSS

Surveyed JUN 11 1984, by P. PAGTER