


T.29S., R.6W., W.M.

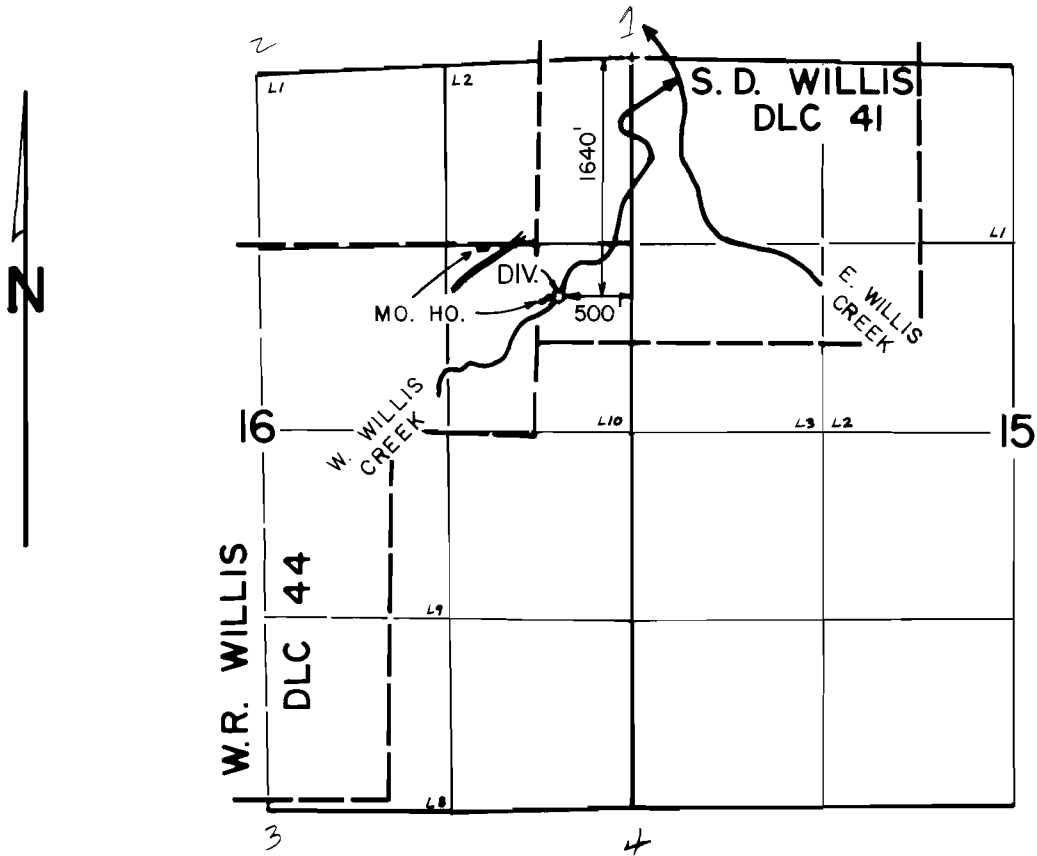

SCALE: 4" = 1 mile

FINAL PROOF SURVEY
UNDER

Application No. 54491 Permit No. 40867.....
IN NAME OF

CHARLES...E...THOUVENEL, SR.

Surveyed SEPT. 26 19.84., by J.E. Cashion.....