


T. 1 N. R. 48 E. W.M.

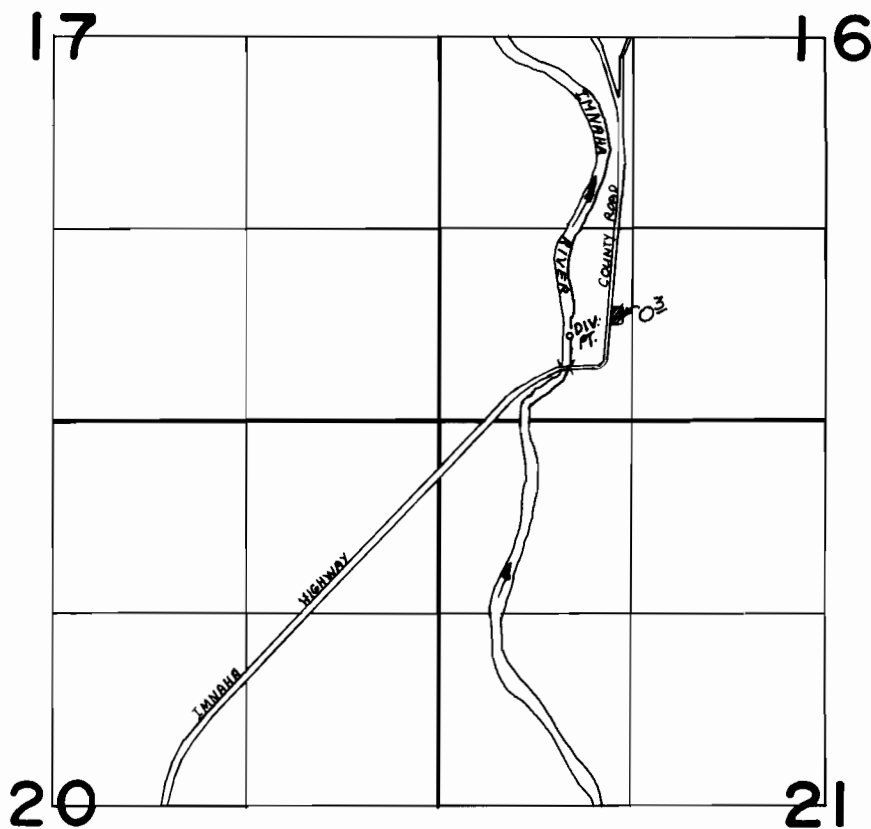

SCALE: 1" = 1320'



DIV. PT. LOCATED 580' N. AND 900' E. FROM S.W. SEC. COR. SEC. 16

FINAL PROOF SURVEY UNDER

Application No. 54721.. Permit No. 41093.....

IN NAME OF

.....**BRADY L. BOTTS**.....

Surveyed8-7..... 1984., by V.L. CHURCH.....