


# T.18S.,R.5W.,W.M.

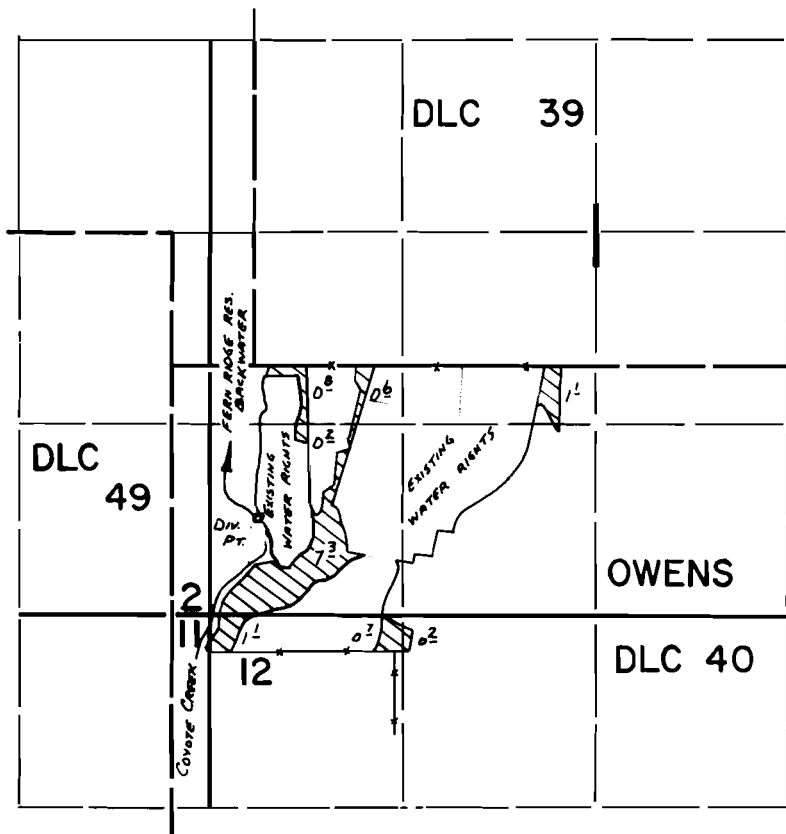

DIV. PT : 1030 FT. S. AND 590 FT. E. FROM NW COR. OWENS DLC 40

## FINAL PROOF SURVEY UNDER

Application No. .54868.. Permit No. ...41156.....  
IN NAME OF

.....**JAMES C. TAPP**.....

Surveyed May... 5... 1982., by L. M. TOLL.....