


T.17S., R.5W., W.M.

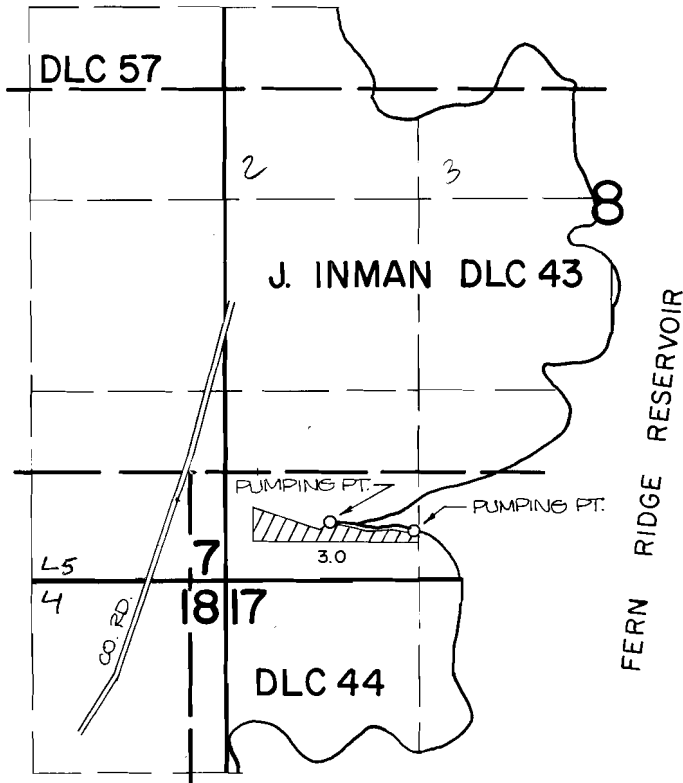

DIVERSION POINT IS LOCATED BETWEEN 400 FT. N. AND 710 FT. E. AND 340 FT. N. AND 1300 FT. E., BOTH FROM THE S.W. CORNER OF SECTION 8.



FINAL PROOF SURVEY
UNDER

SCALE: 4" = 1 MILE

Application No. 57049 Permit No. 43034
IN NAME OF

ESTATE OF ALFRED T. HUMBLE AND MARY L. HUMBLE

Surveyed MAY 8, 1984, by P. Pagan