


T.33 S., R.2 E., W.M.

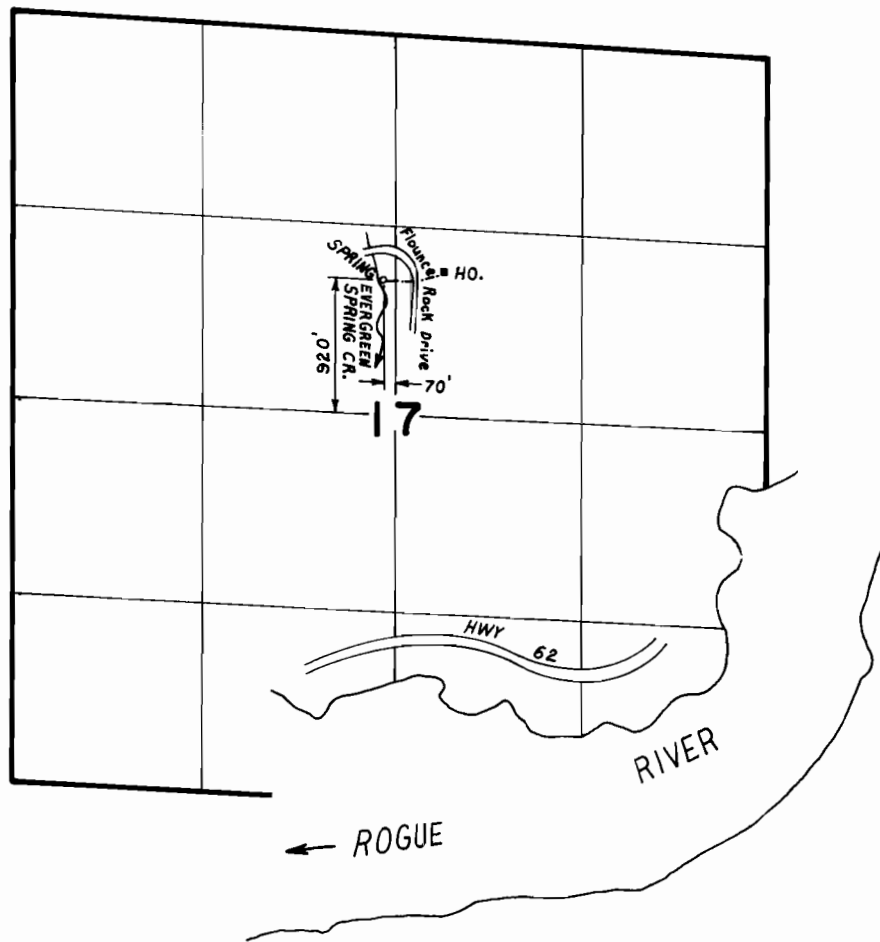

SCALE: 1" = 1320'

**FINAL PROOF SURVEY**  
UNDER

Application No. **58112**... Permit No. **43740**...  
IN NAME OF

**ROBERT C. & MARIE T. THOMEN**.....

Surveyed **JUNE 16**... 19**83**, by **B. S. JAMES**.....