


T. 41 S., R. 12 W., W. M.

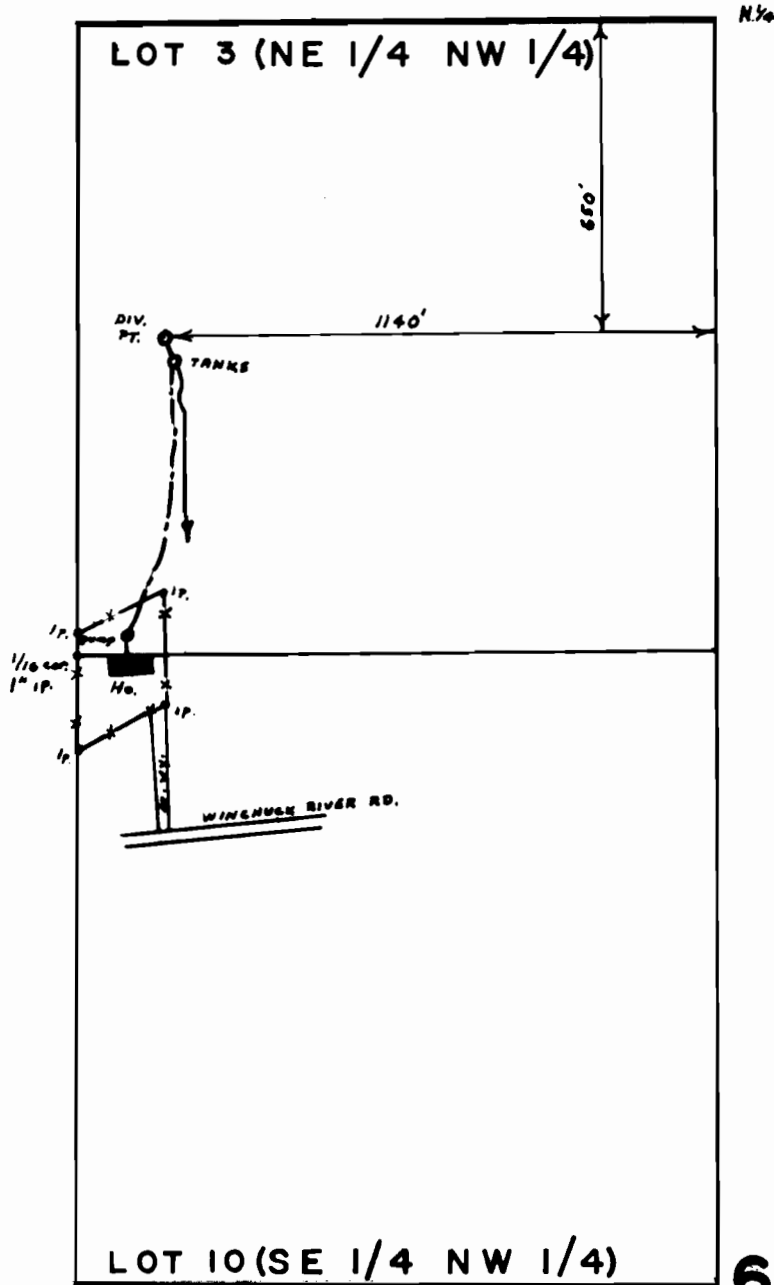

6

LOT 10 (SE 1/4 NW 1/4)

SCALE: 1" = 400'

**FINAL PROOF SURVEY**  
UNDER

Application No. 58100... Permit No. 43838..  
IN NAME OF

.....ARTHUR T. BRAUN.....

Surveyed AUG. 13, 1979 by S. DONALDSON