



T. 33 S., R. 2 E., W. M.

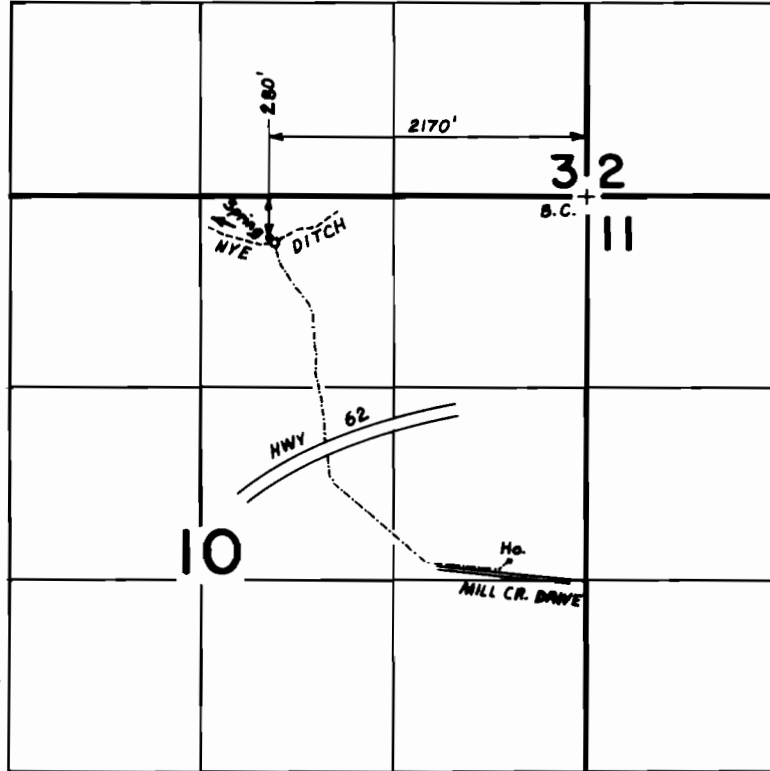

SCALE: 1" = 1320'

T. 32 S., R. 3 E., W.M.

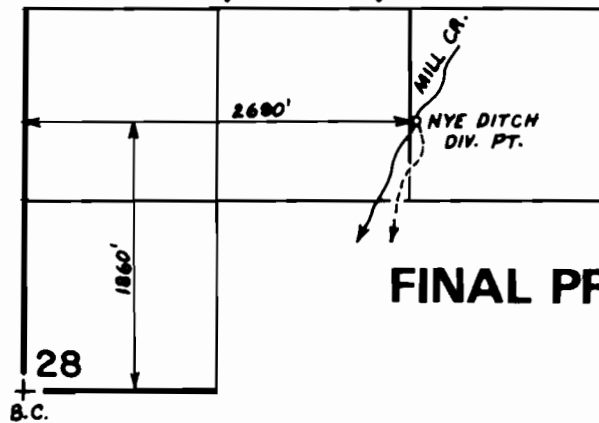

FINAL PROOF SURVEY
UNDER

Application No. 58239 Permit No. 43892
IN NAME OF

ARCHIE V. MCKILLOP

Surveyed MAY 25 1983, by B.S. JAMES