


T. 30S., R. 5W., W.M.

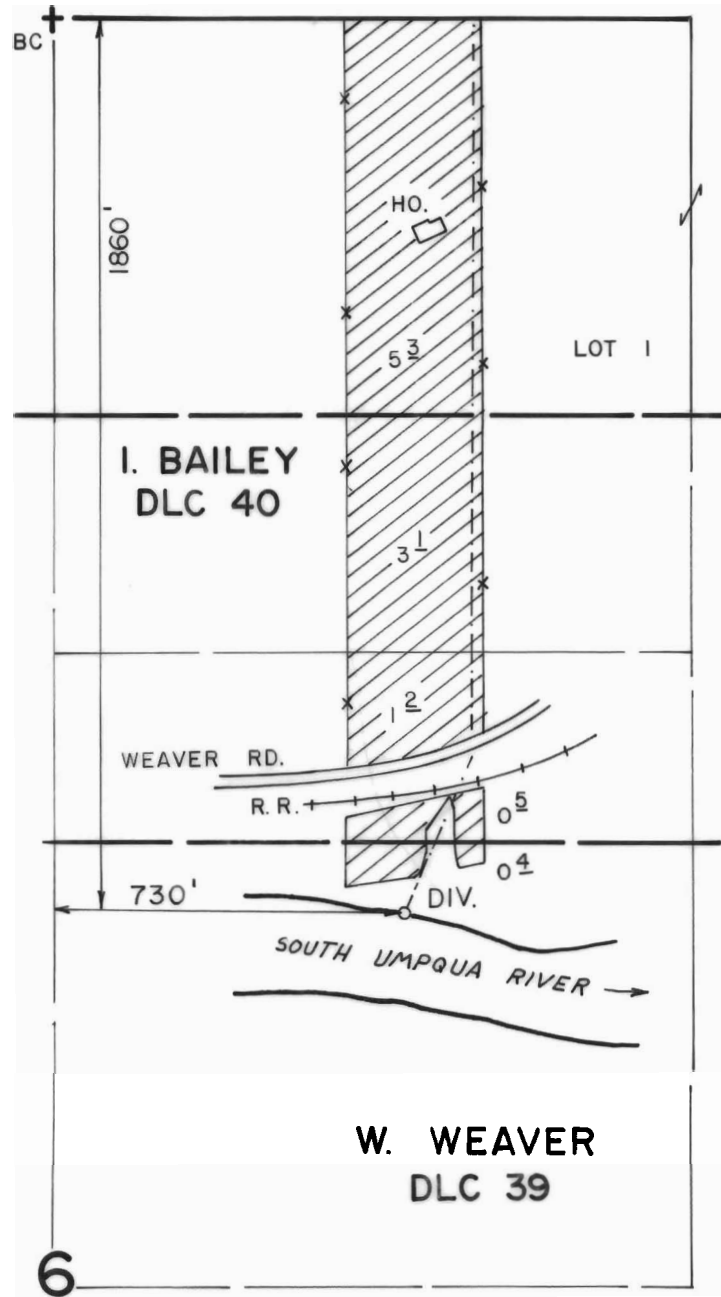

SCALE: 1" = 400'

FINAL PROOF SURVEY
UNDER

Application No. 60041.. Permit No. 45074.....
IN NAME OF

.....**RUSSELL BURTON**.....

Surveyed MAY...29. 19.84, by *J.E. Cashion*.....