


# T. 40S., R. 3 W., W.M.

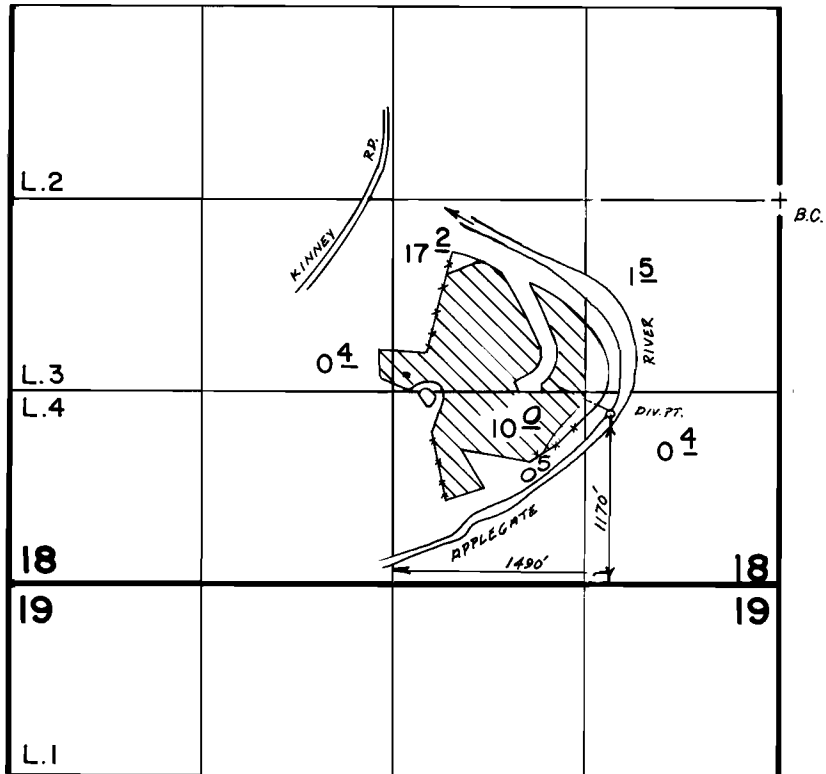

Scale 1" = 1320'

## FINAL PROOF SURVEY UNDER

Application No. 61811... Permit No. 45933...  
IN NAME OF

WILLIAM J. CONNOLLY

Surveyed Oct. 6, 1986, by B.S. JAMES