


RECEIVED

AUG 10 1981

WATER RESOURCES DEPT
SALEM, OREGON

T.38S. R.3W. W.M.

Application No. 62193
Permit No. 46074

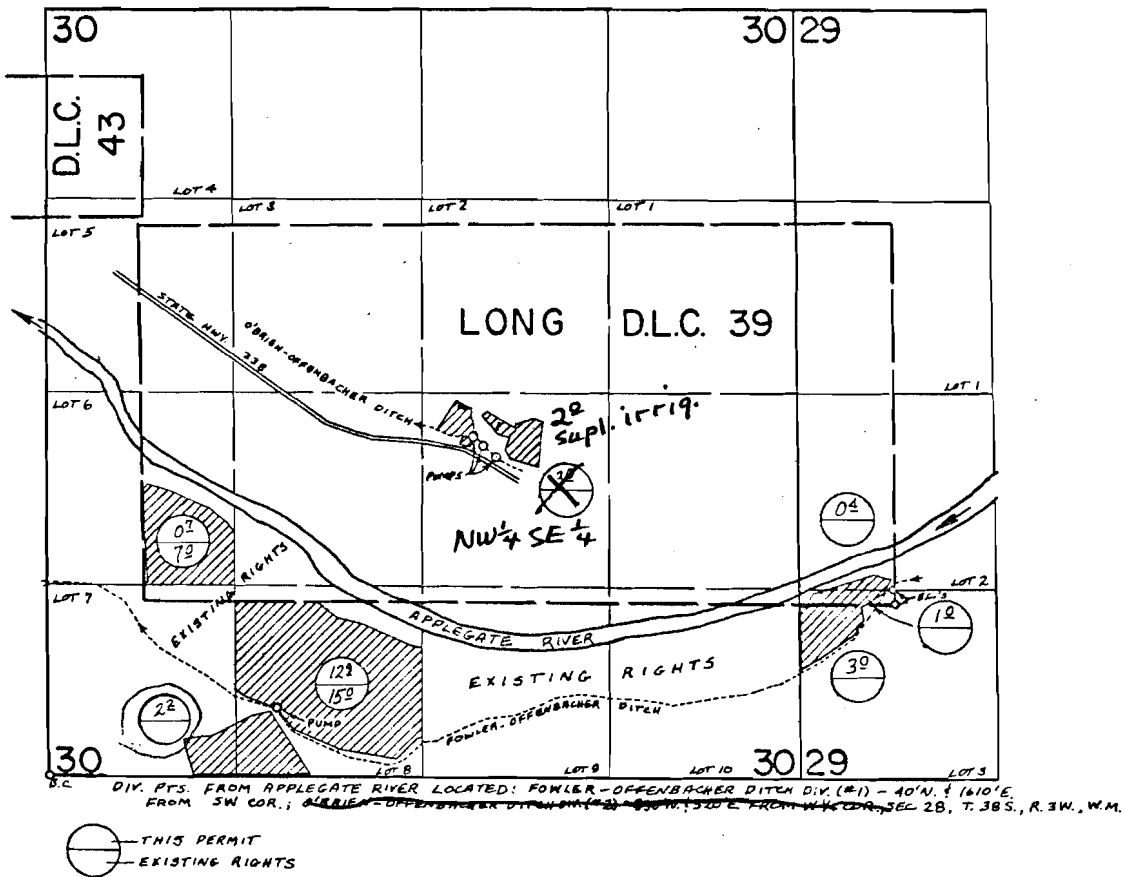

Map to accompany application of Stella Offenbacher to appropriate 4 acre feet of stored water from Applegate Lake Reservoir to irrigate supplementally **FINAL PROOF SURVEY** 2 acres shaded in yellow above. UNDER

O'Brien Offenbacher Ditch diversion is located 2060 ft. S. and 305 ft. East from the NE corner of Sec. 29, T. 38 S., R. 3 W., W.M.

Application No. ~~42715~~ Permit No. ~~31914~~
IN NAME OF

~~THE ESTATES OF LEON & LANCE OFFENBACHER~~

Surveyed AUG. 12-13, 1975, by L. TOLL