


# T. 9 S., R. 5 W., W.M.

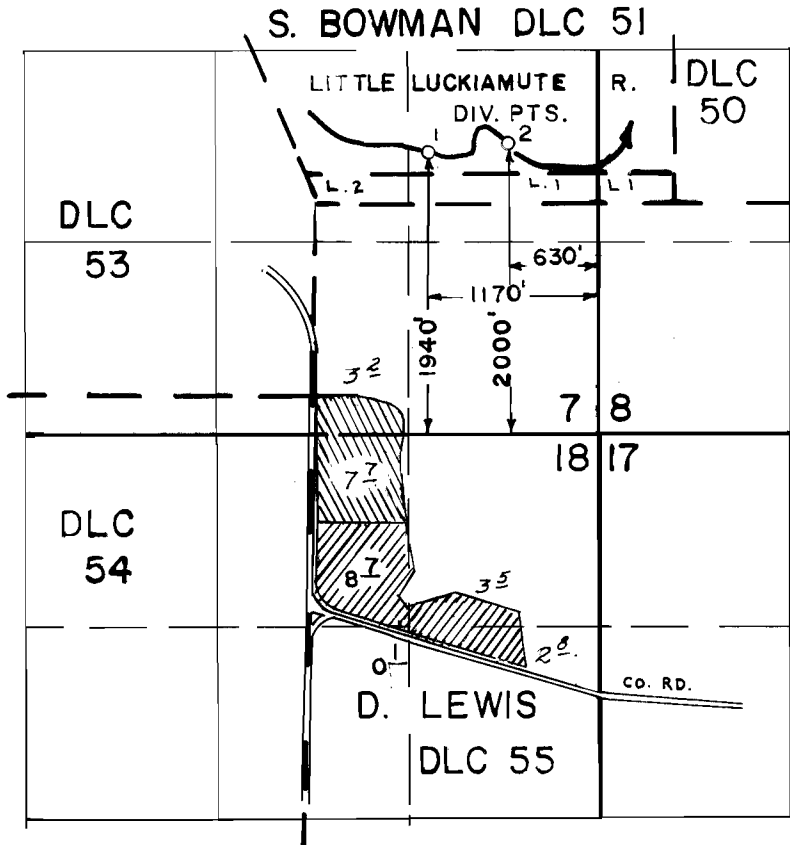

 PRIMARY  
 SUPPLEMENTAL

## FINAL PROOF SURVEY UNDER

Application No. 61768 Permit No. 46238  
IN NAME OF

VERN RATZLAFF

Surveyed SEP. 4, 1984, by P. PAGTER  
JUNE 3, 1987 B.W. BISHOP

REVISED 2-11-88 B.W.B.