


T. 18S., R. 44E., W.M.

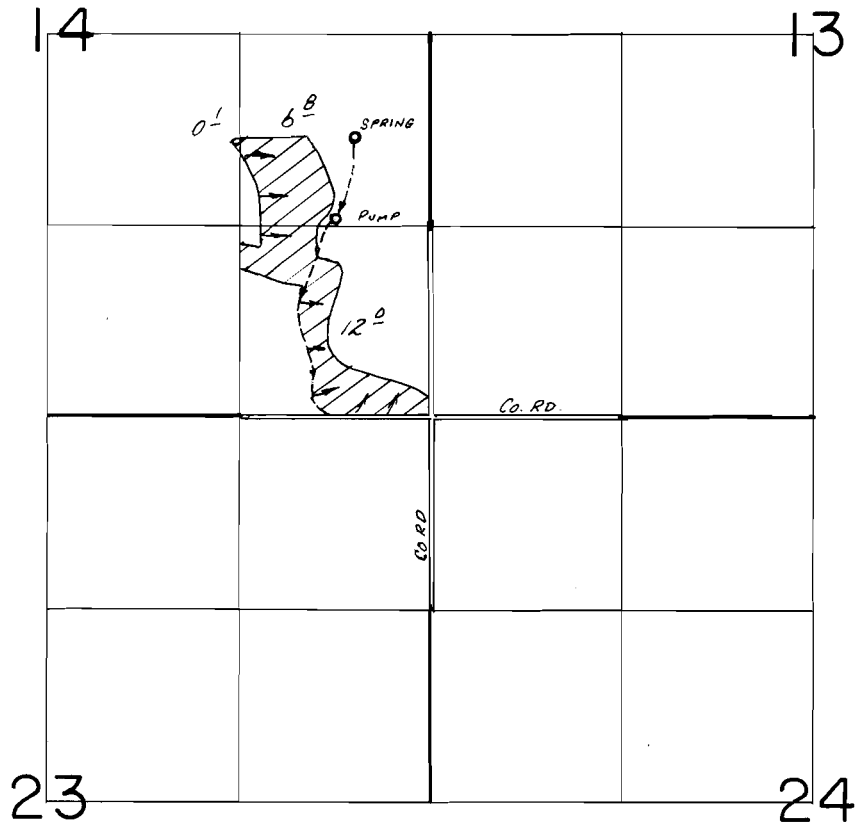

SPRING LOC.: 1940' N & 520' W FROM SE COR. SEC. 14

SCALE: 1" = 1320'

FINAL PROOF SURVEY
UNDER

Application No. 62138... Permit No. 46357.....
IN NAME OF

.....ANTONE G. ROSE.....

Surveyed Jan. 20.... 19.88., by V. L. CHURCH.....