


T.40 S. R.3W.W.M.

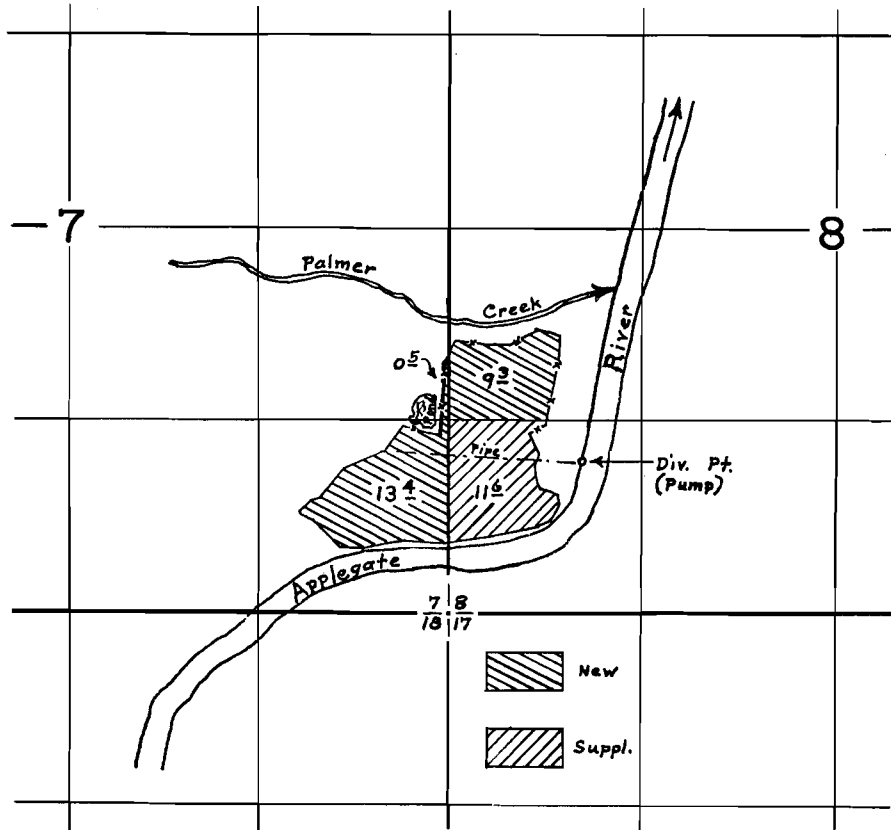

FINAL PROOF SURVEY UNDER

Application No. **30228** Permit No. **23830**...
IN NAME OF

RALPH & MARIAN K. STAVER.....

Surveyed **May 23** 1963, by **CBaker**.....