

RECEIVED

MAR 16 1985

WATER RESOURCES DEPT  
SALEM, OREGON


T. 38 S. R. 8 W. W.M.  
JOSEPHINE COUNTY OR.

4 INCHES = 1 MILE

RECEIVED

MAY 23 1984

WATER RESOURCES DEPT  
SALEM, OREGON

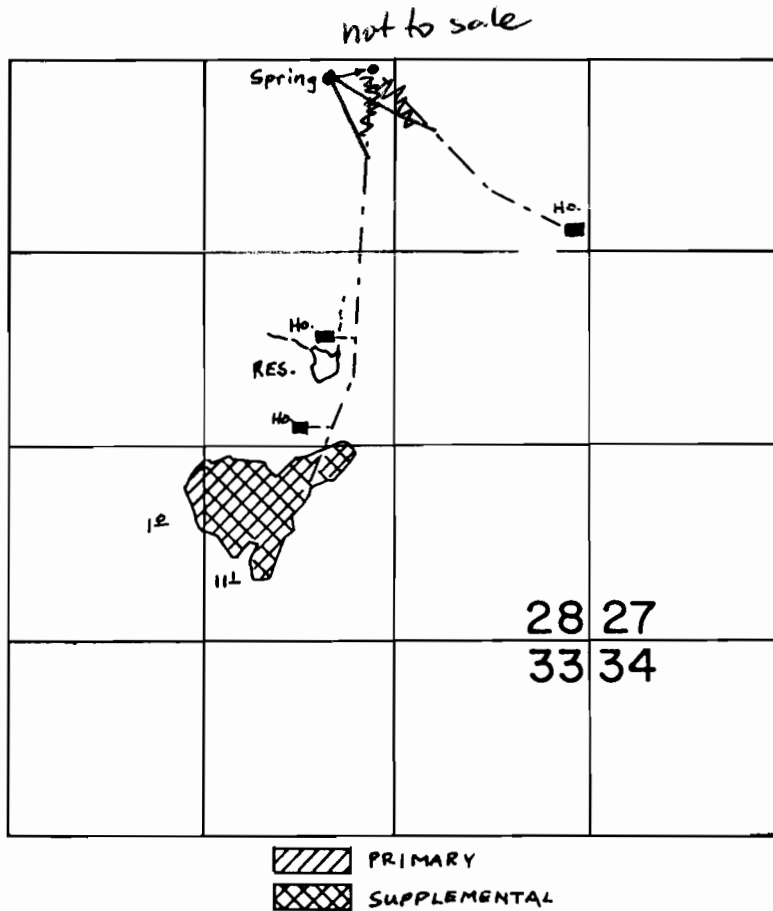

TRIANGLE 3 RANCH

Application No. 68090  
Permit No. 49255