


T.2N.,R.33E.,W.M.

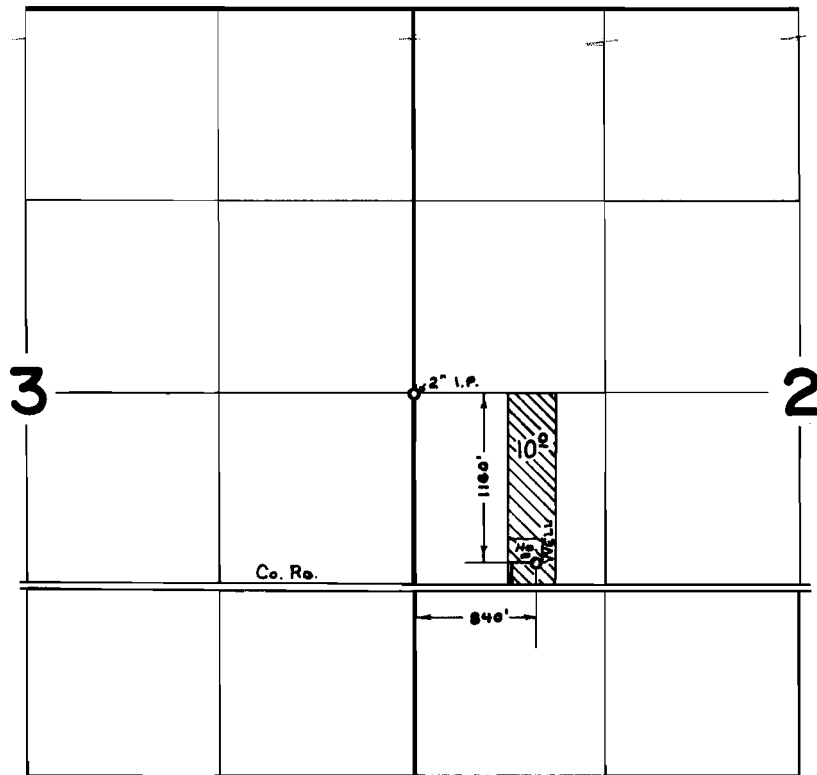

FINAL PROOF SURVEY UNDER

Application No. G-5711 Permit No. G-5174
IN NAME OF

JERRY D. MILLS

Surveyed Aug. 1 1974, by L. Toll