


T. 34 S., R. 3 W., W. M.

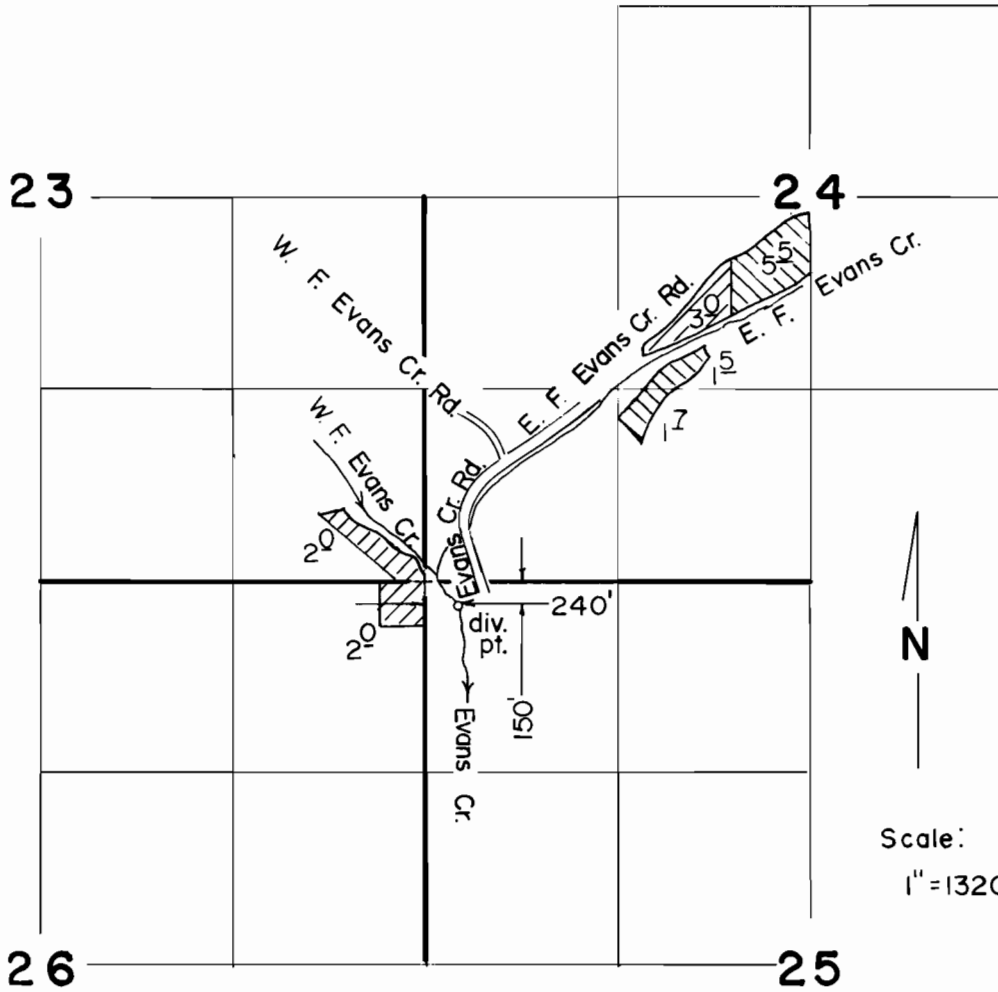

Primary



Supplemental



FINAL PROOF SURVEY

UNDER

TRANSFERS NO. 5139, 5140, 5141, 5142

Application No. Permit No.

IN NAME OF

.....ROBERT M. STOREY.....

Surveyed JUN....3... 19.87., by B....S.....JAMES...

Scale:
1" = 1320'