


# T.9&10S.R.2 W.W.M.

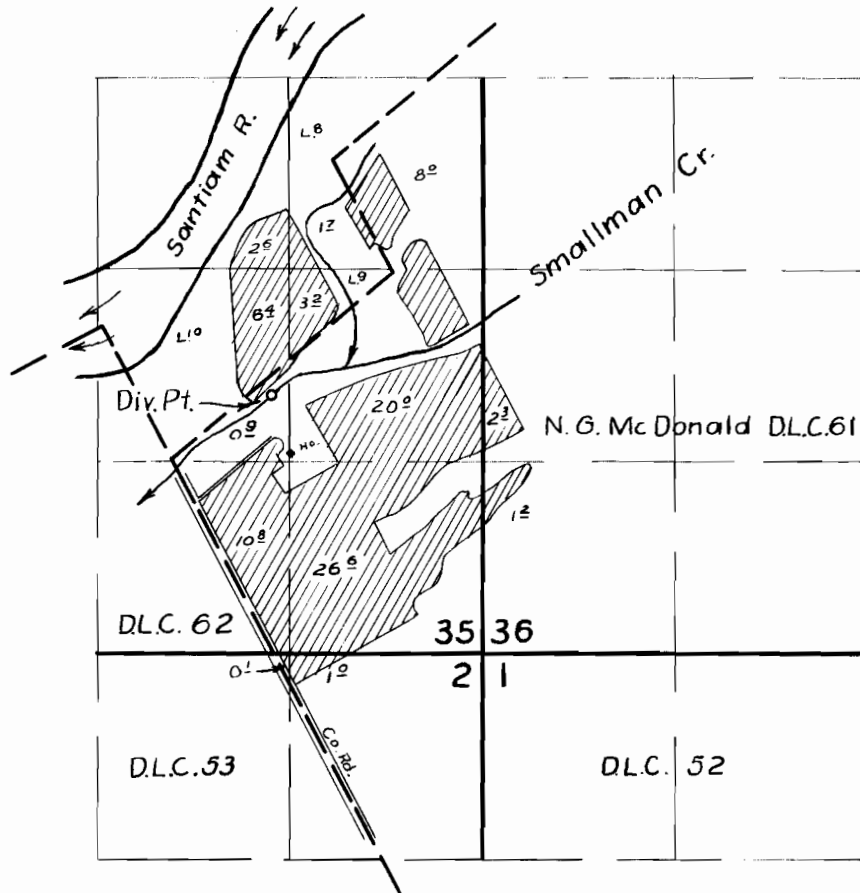

## FINAL PROOF SURVEY UNDER

Application No. 26545 ... Permit No. 20802 ...  
IN NAME OF

*Ora Trollinger*

Surveyed Mar. 21 1957, by *M. Bish*