


P-46301
C-57694

T. 13S., R. 28E., W.M.

SCALE 1"=1320'

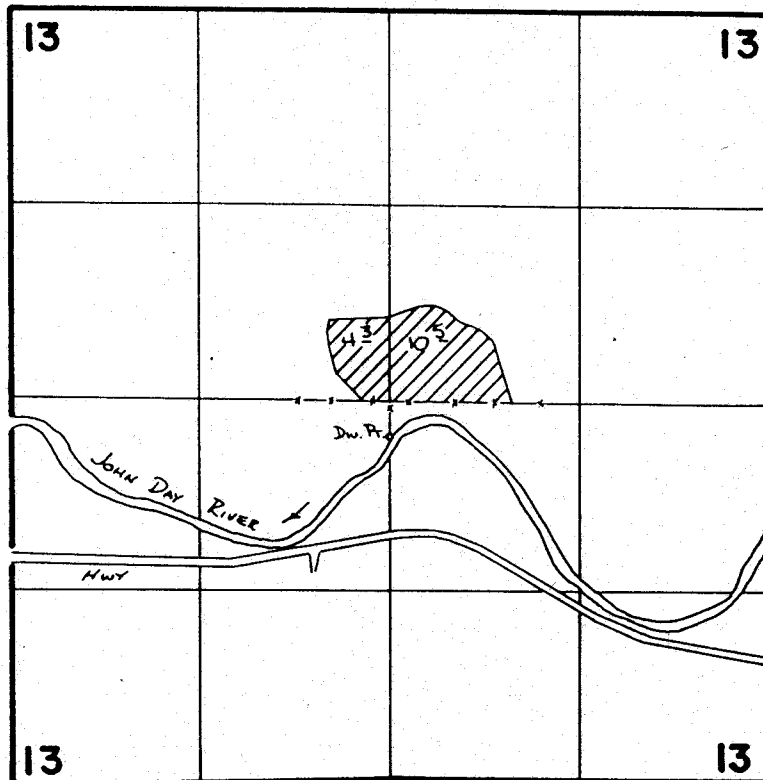

Div. Pt. Loc: 240'S. FROM CENTER COR. SECTION 13

FINAL PROOF SURVEY
UNDER

Application No. **61855**. Permit No. **46301**..
IN NAME OF

MARY HILDA TIRICO

Surveyed 3-21-1984, by V.L. Church