


T#3577  
To

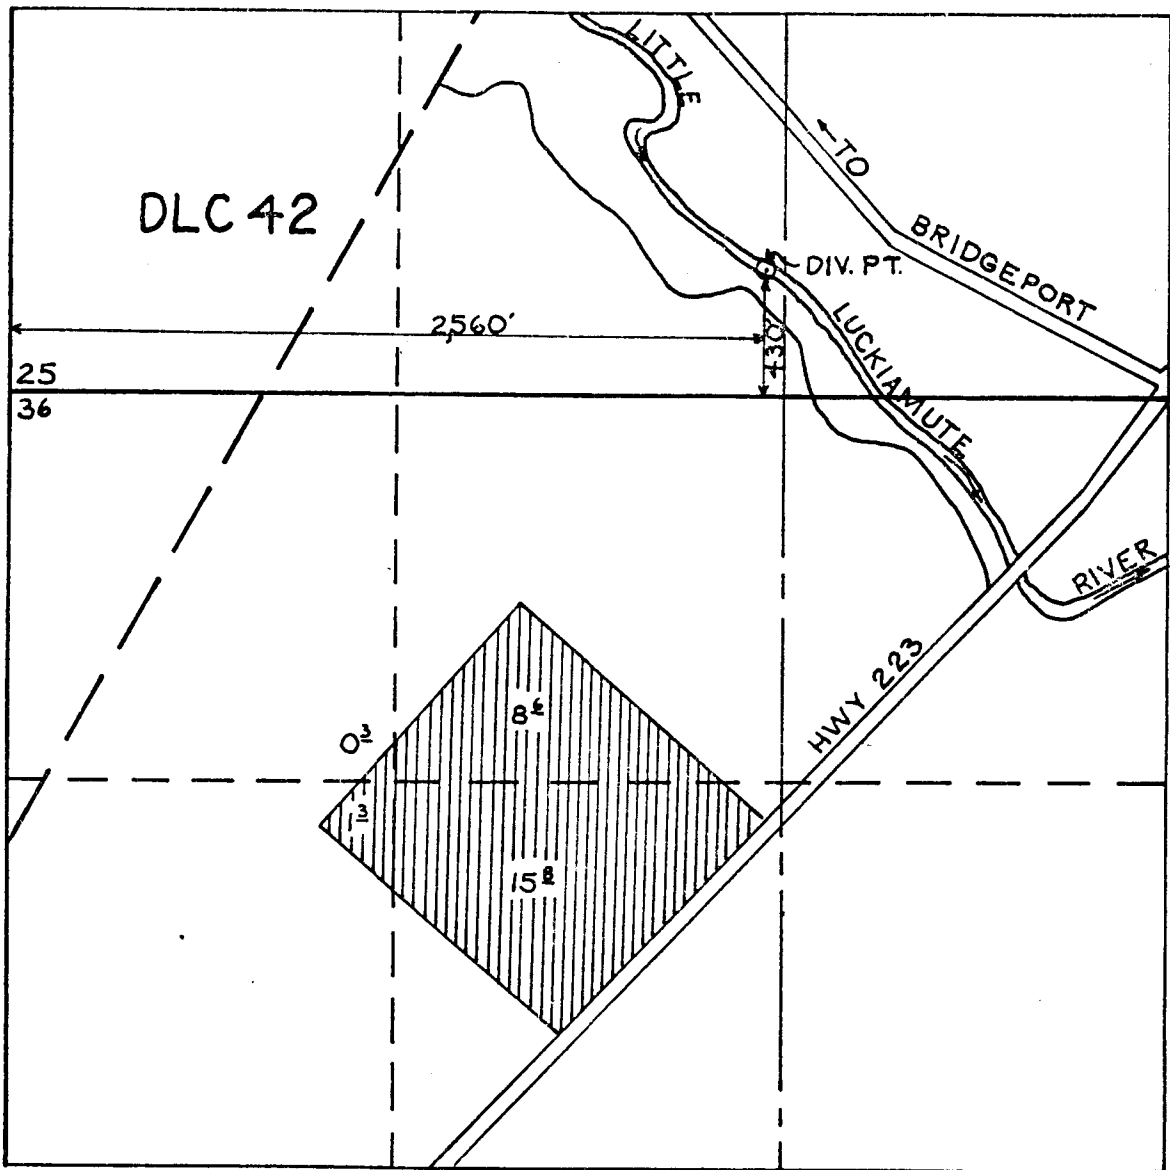

KENNETH GARDNER

T8S R6W WM.

AREA TO BE IRRIGATED IIIII