


T.8&9S. R.5&6W. W.M.

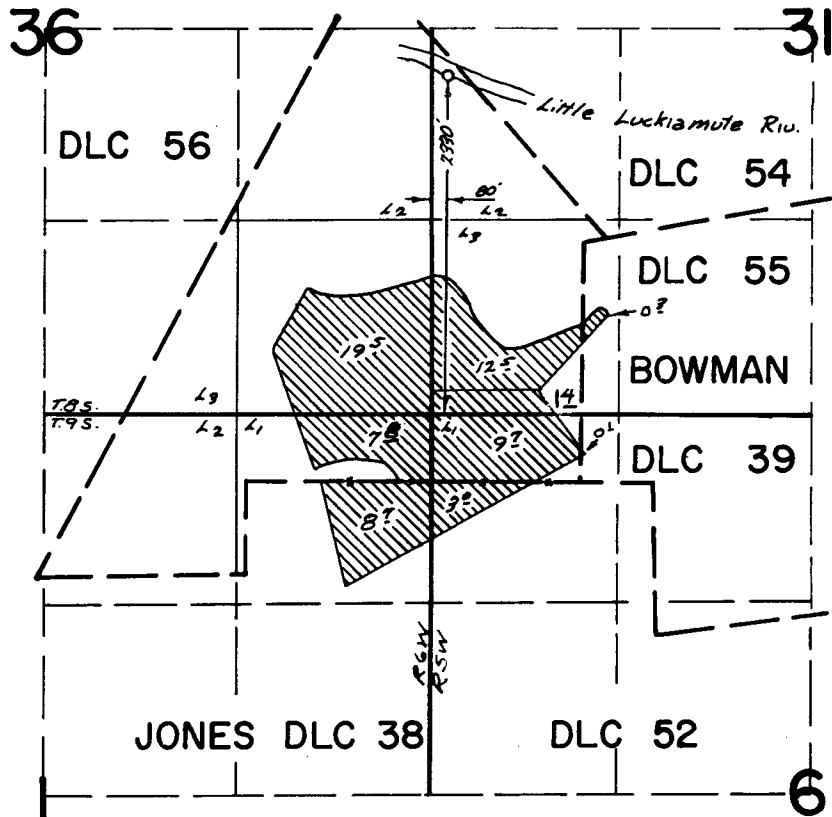

T# 3542  
To

**FINAL PROOF SURVEY**  
UNDER

Application No. 41792 Permit No. 31286  
IN NAME OF

DR. C. J. MOSER

Surveyed APRIL 2 19 77 by R. B. Mucken