


T. 9S., R. 5W., W.M.

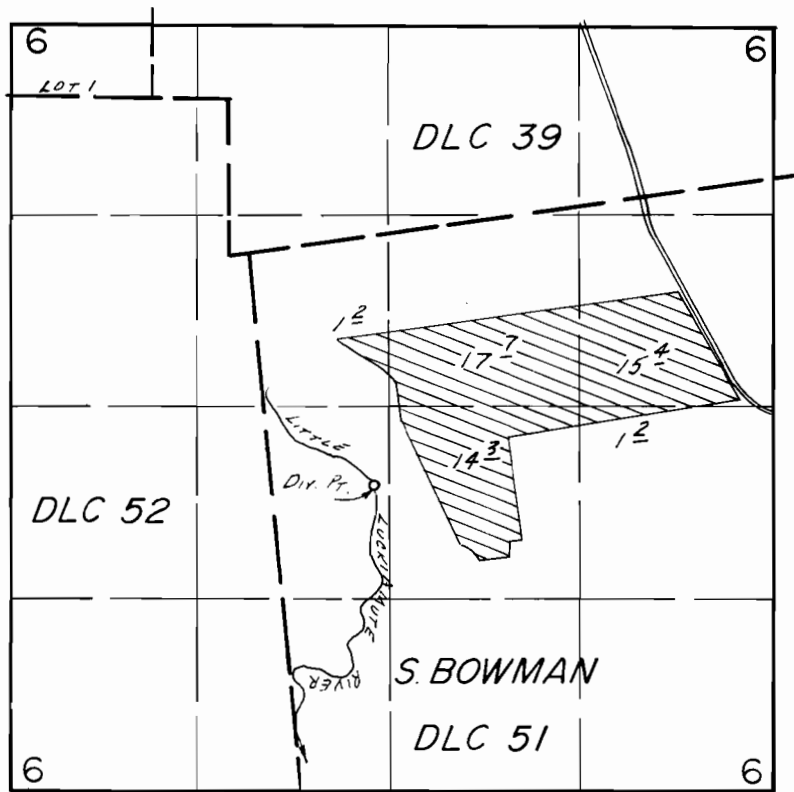

Div. Pt. Loc.: 1560'S. & 870'E. FROM NW COR. S. BOWMAN DLC 51.

SCALE: 1" = 1320'

FINAL PROOF SURVEY
UNDER

Transfer No. 3543

IN NAME OF

..... J. L. HENDRICKSON

Surveyed Aug. 8, 1983, by L. M. TOLL

INSPECTION

LBW