

T. 6 S., R. 1 W., W.M.



FINAL PROOF SURVEY

UNDER

Application No. 19856..... Permit No. 15435.....


IN NAME OF

..... St. Benedicts Abbey

Surveyed May 27..... 1954., by H. L. Coffman

DFN 1D 29

T.6S. R.1W.W.M.

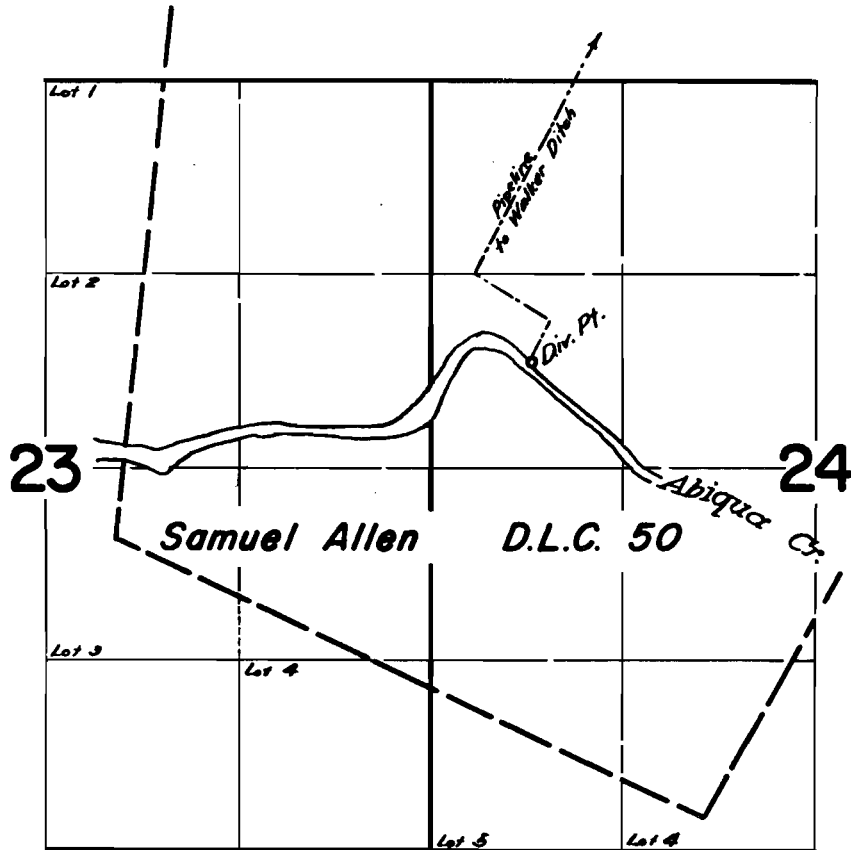

FINAL PROOF SURVEY UNDER

TRANSFER M-121

Application No. Permit No.

IN NAME OF

MT. ANGEL ABBEY

Surveyed April 16, 1962, by *R. H. Jackson*