


# T.26S.R.4W.W.M.

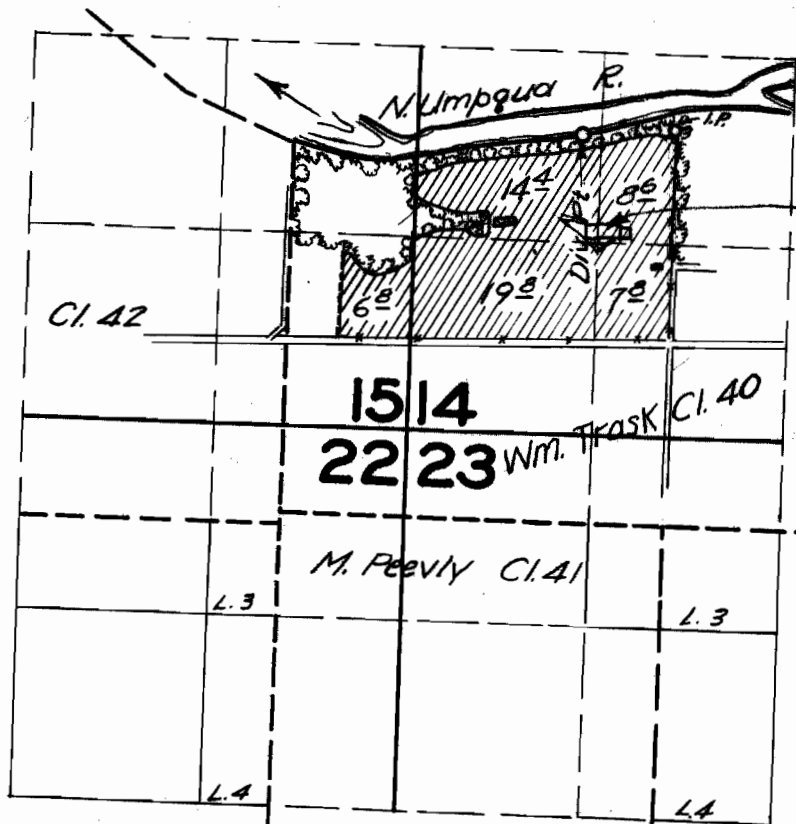

Change in Type of use  
T-5334  
canceled

## FINAL PROOF SURVEY UNDER

Application No. 18858 Permit No. 11198

IN NAME OF

R. H. Franks

Surveyed July 20 1954, by H. L. Coffman