

WATER RIGHT--FANNO CREEK

SECTION 26 T8S R8W W.M.

Scale 1"=600' October 7, 1955

2



I CLIFFORD C. McLEAN of Dallas, Oregon do hereby certify that this map was made from notes taken during an actual survey by me or under my immediate supervision on September 30 and October 3-5, 1955; that the monument shown on this map consisting of 1"x38" iron pipe is N2°09'E 2549.6 feet from the southwest corner of section 26, R8W, T8S, W.M.

Clifford C. McLean

Pipe line

Fanno Creek

Dam - Set 1"x38" iron pipe at point of diversion

Tie - N2°09'E (√2130') 2549.6 feet

Valve house for industrial use



Chlorinator - Domestic use

27 26
34 35

Valsetz Lake

Industrial Area

Valley & Sletz Railroad

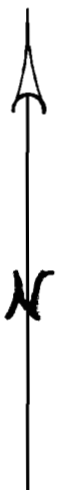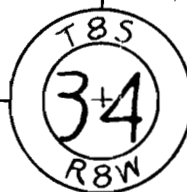

Application No. R-30405
Permit No. 30406 24211
R-1863

R.B.