


T. 13 S. R. 32 E. 33 E. W.M.

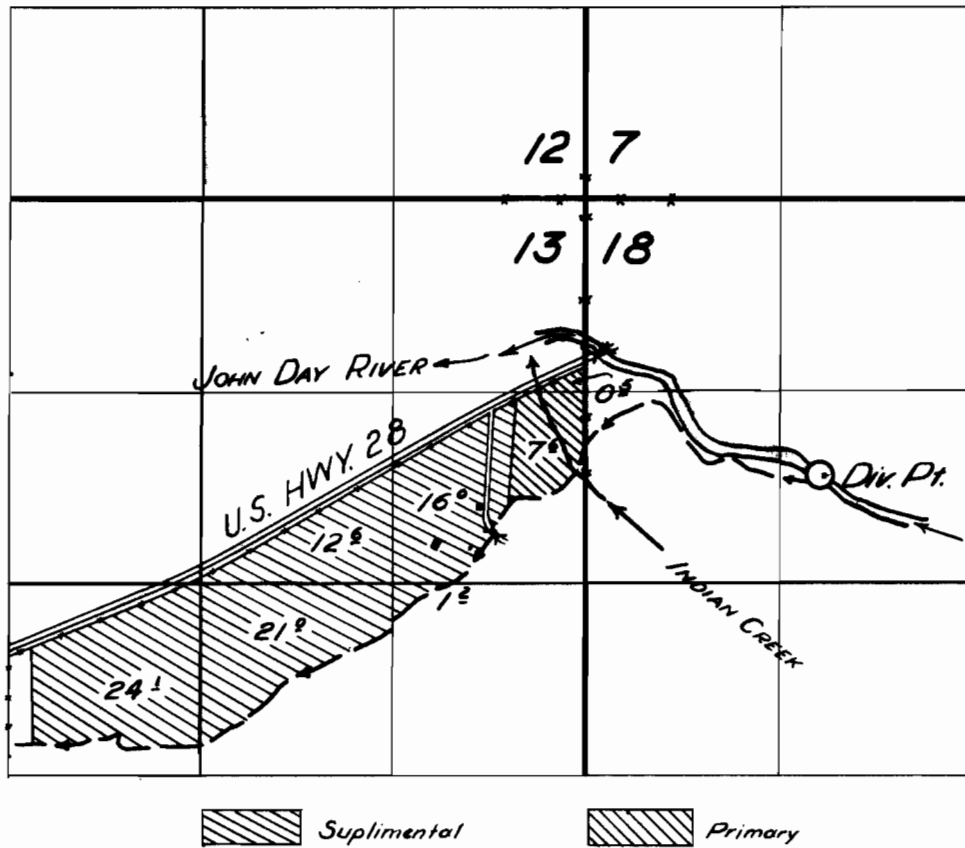

FINAL PROOF SURVEY
UNDER

Application No. 23738 Permit No. 18742
IN NAME OF

HERBERT RICCO

Surveyed 26 Oct 1955, by [Signature]