


T. 98.10 S. R. 2 W. W.M.

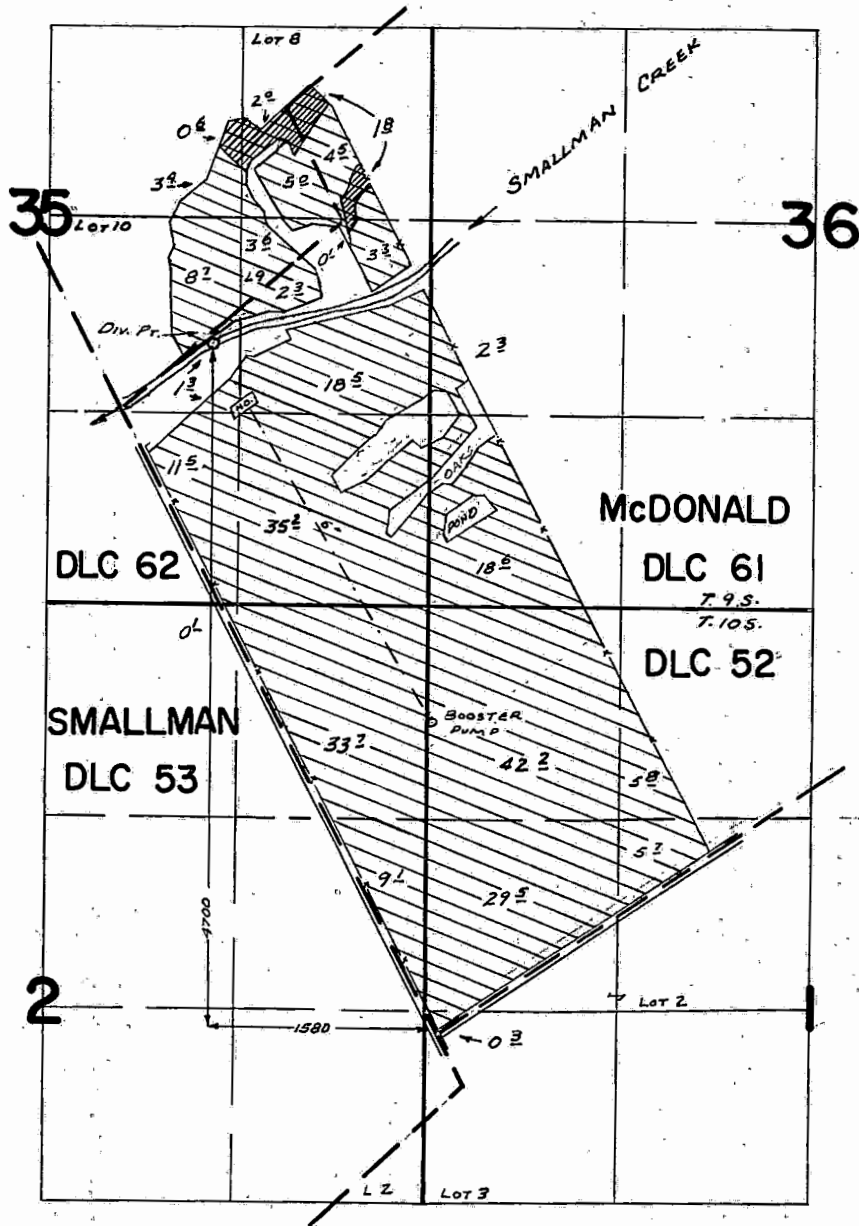

FINAL PROOF SURVEY

UNDER

SUPP. TO WELL PERMIT # 2235
SMALLMAN CREEK



Application No. 42256 Permit No. 31615
IN NAME OF

WALTER D. & PATRICIA R. MILLER

Surveyed MAR. 27, 1969, by W. RUPPERT

