


T.29 S., R.14 W., W.M.

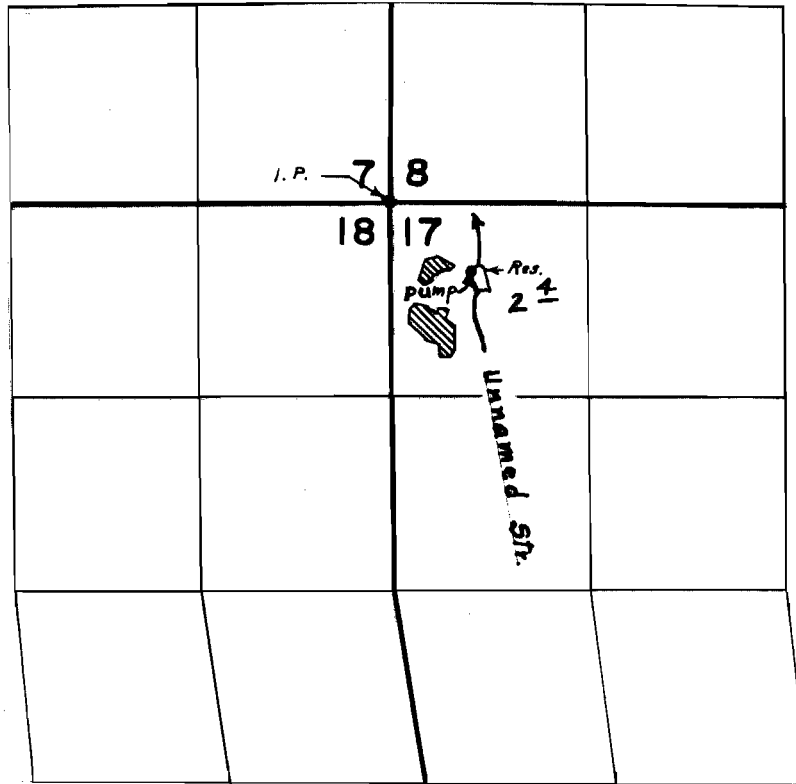

Div. Pt. located 430' S. & 600' E. from N.W. Cor. Sec. 17

FINAL PROOF SURVEY
UNDER

Application No. 41906 Permit No. 31372
IN NAME OF

.....ROBERT L. & HELEN M. ATEN.....

Surveyed July 18, 1972, by L. E. Gould