


T.39S. R.25 & 26E.W.M.

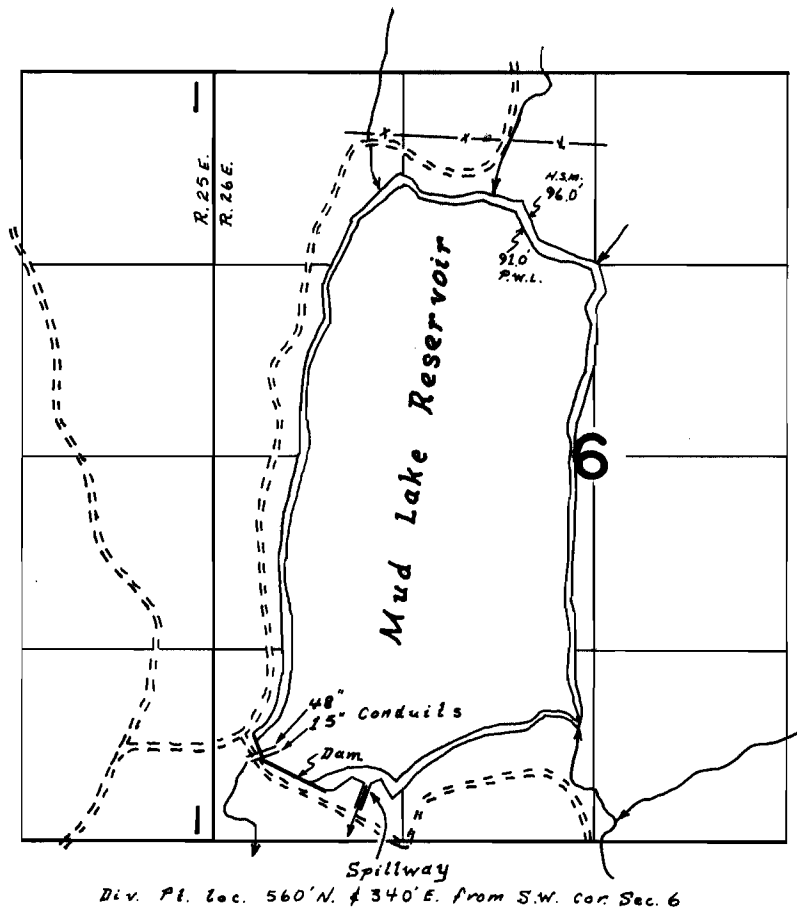

Div. Pt. Loc. 560' N. & 340' E. from S.W. cor Sec. 6

**FINAL PROOF SURVEY  
UNDER**

Application No. R-38497 Permit No. R-3272  
IN NAME OF  
U. S. DEPARTMENT OF THE INTERIOR  
BUREAU OF LAND MANAGEMENT

Surveyed 14 Sept 1972, by L.E. Gould