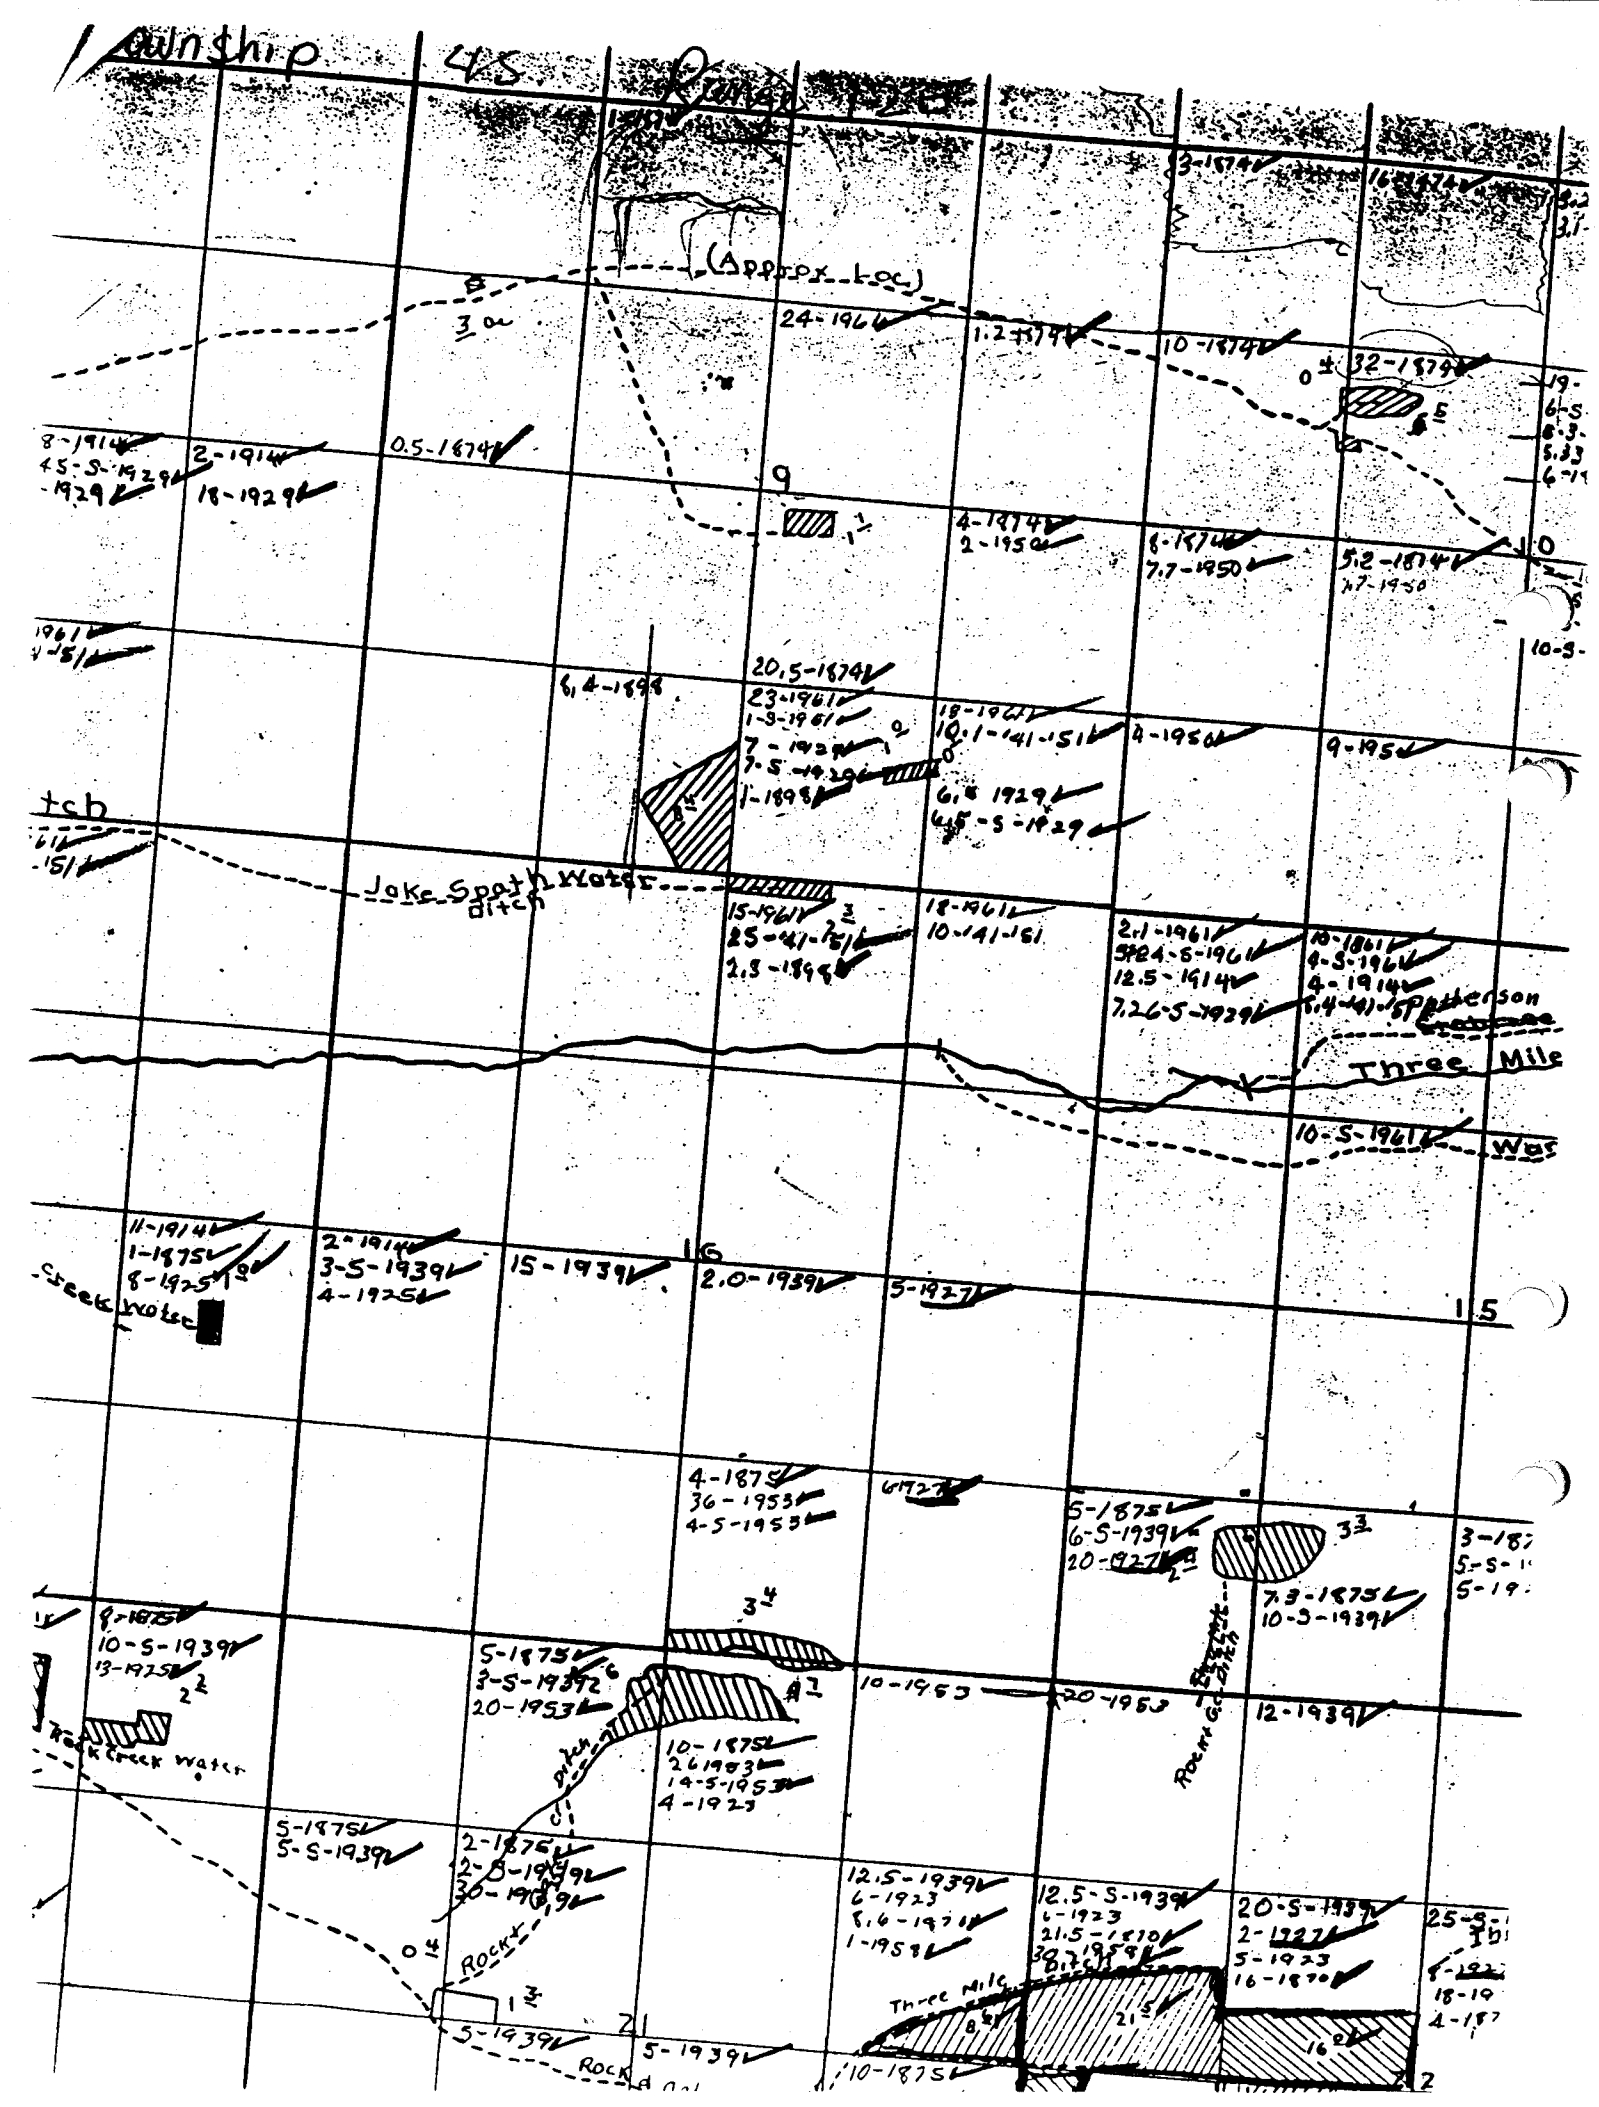
Township 45 Range 12
(Approx. loc.)
Jake Spath Water ditch
Three Mile
Rock Creek Water
Rock Creek Water
Rock Creek Water
Three Mile
Patterson
ROCK
ROCK