


# T. I. S. R. 3 W. W. M.

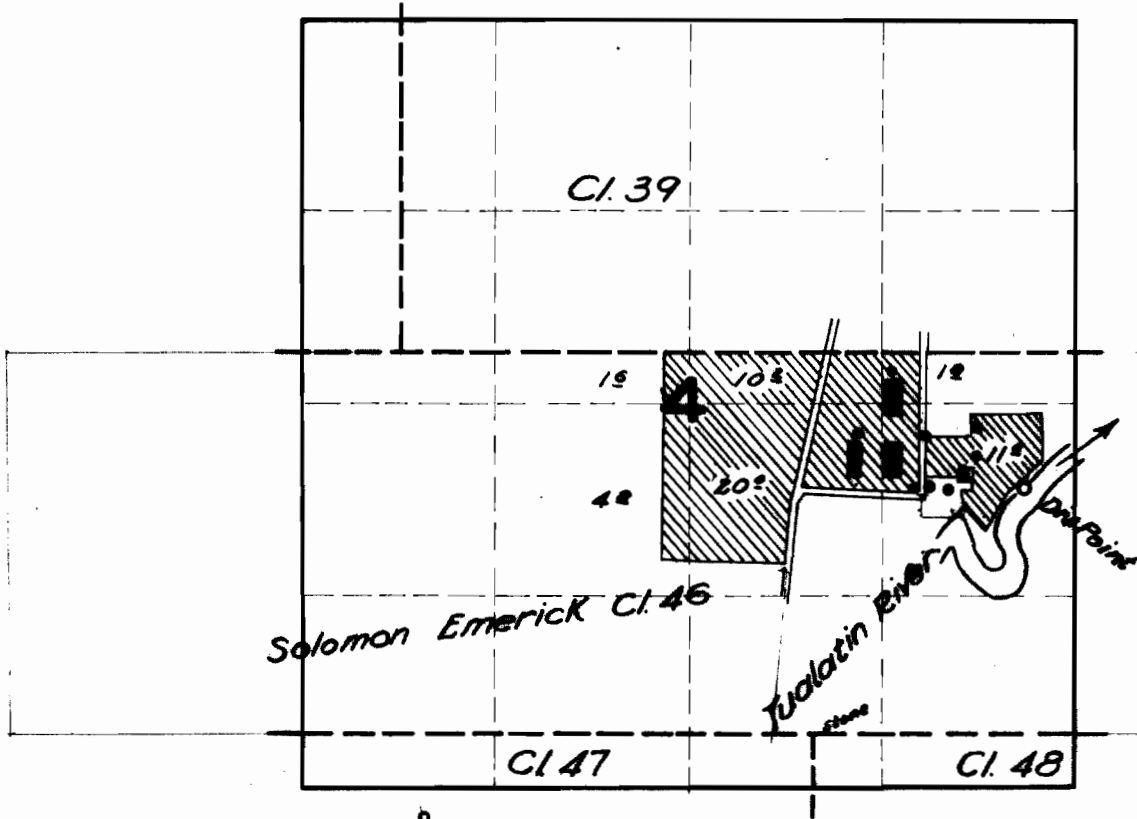

## FINAL PROOF SURVEY

UNDER

21020

16442

Application No. 23822..... Permit No. 18775.....

*File* IN NAME OF

WASHINGTON COUNTY FLAX GROWERS

Surveyed May 12, 1952, by H. L. COFFMAN.