


T. 28 S., R. 12 W., W.M.

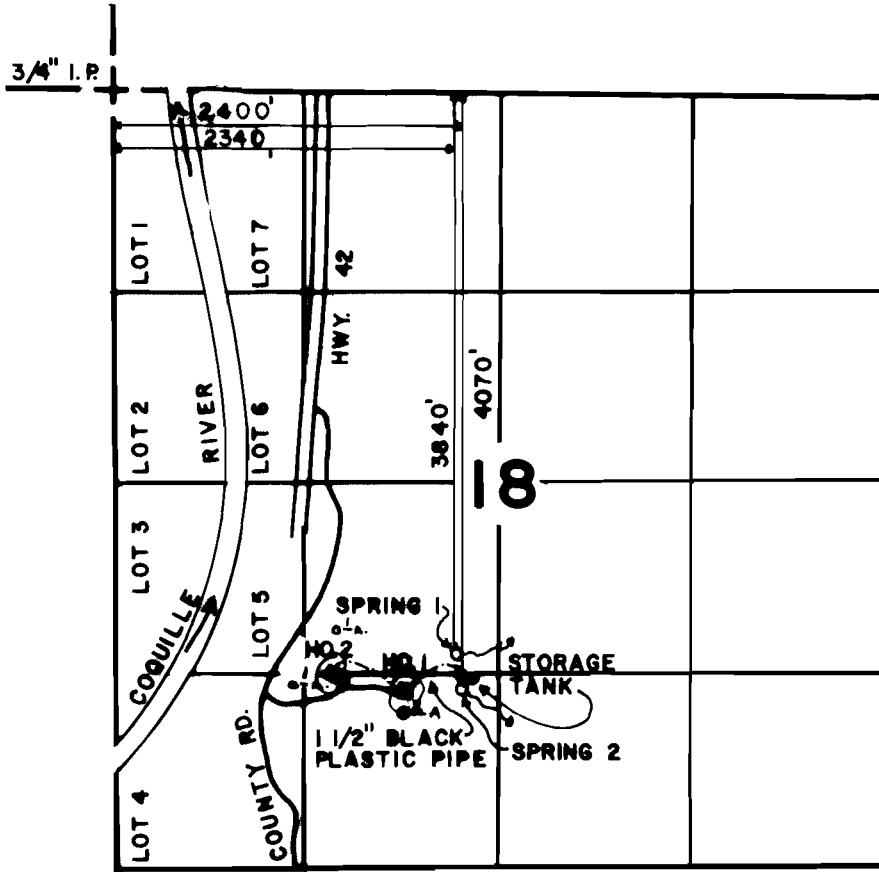

2

SCALE: 4" = 1 MILE

FINAL PROOF SURVEY UNDER

Application No. 54526 Permit No. 40895
IN NAME OF

EDWARD J. &/OR IRMA J. ARNETT

Surveyed AUG 28 1965, by J.M. SCHMORDE